

SERVICES PENETRATIONS AND FIRE DAMPERS/COLLARS.

02 EXISTING EXTERNAL MASONRY WALLS GENERALLY (THAT ARE TO REMAIN

REINFORCEMENT AS WEBER OR SIMILAR APPROVED PRODUCT.

SPECIALIST HERITAGE FEATURES, METHODS AND FINISHES TO BE APPROVED BY HERITAGE & PLANNING.

M60/100

AS EXTERNAL), TO BE RUBBED DOWN, ANY DEFECTIVE/LOOSE PLASTER TO BE HACKED OFF AND REPAIRED, PREPARED TO RECEIVE A BONDING PRIMER AGENT IN ORDER TO TAKE THROUGH COLOUR ACRYLIC RENDER WITH HIGH POLYMER CONTENT BASECOAT AND ALKALI—RESISTANT MESH

03 EXISTING EXTERNAL WALLS (REMAINING EXTERNAL) TO BE LINED INTERNALLY WITH INSULATION—BACKED HIGH IMPACT RESISTANT PLASTERBOARD, CLASS O FIRE RATED, AS GYPROC THERMALINE PIR, APPROX 38mm THICK OVERALL, WITH INTERGRAL VAPOUR MEMBRANE, TAPED AND JOINTED, FIXED THROUGH TO EXISTING WALL ON 25mm DEEP OMEGA RAIL FRAMING WITH COMPRESSED ROCKWOOL INFILL. OVERALL WALL CONSTRUCTION, TO ACCHEVE AN ELEMENTAL 'IL' VALUE OF DATOM WARD

05 EXISTING EXTERNAL WALLS WHICH ARE TO REMAIN AS INTERNAL TO BE

06 ALLOW FOR CONTINUOUS DPM TO BE TAKEN UP AND LAPPED/SEALED INTO INJECTED DPC AT MINIMUM 150MM ABOVE EXTERNAL FFL.

07 ALLOW FOR FORMING OF VENT HOLES WITHIN EXISTING WALLS INCLUDING

08 HIGH LEVEL DOUBLE GLAZED ALUMINIUM FRAMED OPENABLE AND FIXED CLERESTORY WINDOWS TO AID NATURAL VENTILATION INCLUDING INTEGRATED AUTOMATED DIM-OUT BLINDS AS SILENTGLISS OR SIMILAR

09 NEW CEILINGS GENERALLY TO BE MF CEILING EXPOSED GRID AND TILE SYSTEM BY ARMSTRONG, CORTEGA —TEGULAR EDGE OR SIMILAR APPROVED PRODUCT. REFER TO G.AS FOR CEILING TYPES.
ALLOW FOR INTEGRATED VENTILATION GRILLES FOR PASSIVENT STACK VENTILATION TO UPPER FLOOR CLASSROOMS TO NEW BUILDINGS.

10 ALLOW FOR DEEP-FLOW PPC ALUMINIUM GUTTERS AND DOWNPIPES WITH

CONCEALED JOINTS AND WALL FIXINGS AS ALUMASC OR SIMILAR

PERFORATED STAINLESS STEEL (OR SATIN NICKEL) GRILLES WITH INTEGRATED INSECT MESH. COLOUR, MATERIAL TBC SUBJECT TO APPROVAL

RUBBED DOWN, ANY DEFECTIVE/LOOSE PLASTER TO BE HACKED OFF AND REPAIRED, PREPARED TO RECEIVE THROUGH COLOUR ACRYLIC RENDER WITH HIGH POLYMER CONTENT BASECOAT AND ALKALI-RESISTANT MESH

WALL CONSTRUCTION TO ACHIEVE AN ELEMENTAL 'U' VALUE OF 0.40W/M2K OR BETTER. ALL EXISTING NATURAL STONE FEATURES/SURROUNDS TO RECEIVE SPECIALIST TREATMENT, CLEANING AND PROTECTIVE SEALING TO REMAIN EXPOSED TO APPROVAL OF HERITAGE & PLANNING.

FOR CONSTRUCTION

rev | date | amendments

NOTES:

DO NOT SCALE OFF THIS DRAWING. CHECK DIMENSIONS ON SITE PRIOR TO COMMENCEMENT. THIS DRAWING IS THE COPYRIGHT OF WSRM ARCHITECTS LTD. AND MUST NOT BE COPIED OR REPRODUCED, IN PART OR IN WHOLE, WITHOUT PERMISSION OF WSRM ARCHITECTS LTD. TO BE

READ IN CONJUNCTION WITH OTHER RELEVANT

CONSULTANTS INFORMATION.

A 31.01.2014 ISSUED FOR CONSTRUCTION

B 11.04.2014 D+W REFERENCES ADDED

C 02.05.2014 D+W ADDITIONAL REFS ADDED

WSRM architects

1.2.20 EUROTOWERS PO BOX 474 **GIBRALTAR**

21 PROPRIETARY, THERMALLY BROKEN ALUMINIUM CURTAIN WALLING TILT &

TURN AND FIXED PANE DOUBLE GLAZED WINDOWS BY TECHNAL REF TECHNAL REF SSG SYSTEM. ALLOW FOR FRAMED, GUIDED AUTOMATED

WINDOWS AND FIXED PANE DOUBLE GLAZED WINDOWS BY MARVIN OR SIMILAR SYSTEM. ALLOW FOR FRAMED, GUIDED AUTOMATED SOLAR

OVER 100mm SAND CEMENT SCREED WITH EMBEDDED CHILLING/HEATING PIPEWORK TO M&E DESIGN OVER 100mm NON-COMPRESSIBLE INSULATION AS KINGSPAN THERMAFLOOR TF70 OR SIMILAR OVER SUSPENDED BEAM

24 VITRAL SKY VISION FIXED ROOF GLAZING SKYLIGHTS FOR FLAT ROOFS, OR SIMILAR APPROVED SYSTEM, COMPOSED OF MODULAR SKYLIGHT UNIT WITH INTEGRATED KERB UPSTAND, HERMETICALLY SEALED DOUBLE GLAZED UNIT WITH LOW E, IMPACT RESISTANT, SOLAR CONTROL GLAZING. OUTER FACE OF EXTERNAL PANEL TO BE SCREEN PRINTED IN PATTERN/COLOUR TBC FRAMING TO BE PPC EXTRUDED ALUMINIUM, THERMALLY BROKEN, TO

25 FEATURE ATRIUM ROOF COVERING, CENTRE-OPENING SLIDING THERMALLY

26 ALLOW FOR FEATURE MOTORISED SOLAR SHADING BLINDS TO UNDERSIDE OF RETRACTABLE ROOF OVER COURTYARD AND TO CONTINUOUS ROOFLIGHT TO UPPER CIRCULATION AREA OF PRIMARY SCHOOL, AS

SILENTGLISS OR SIMILAR. ALLOW FOR SUPPORT / CABLE/ RAIL

27 FEATURE ATRIUM VERTICAL PANELS IN THERMALLY BROKEN ALUMINIUM

28 EXTERNAL AUTOMATED CONTROLLABLE BRISE SOLIEL AS TECHNAL SUNEAL OR SIMILAR EXTERNAL PPC ALUMINIUM LOUVRE SYSTEM. ALLOW FOR

29 EXISTING VENT HOLES TO BE RETAINED TO AID IN NATURAL VENTILATION STRATEGY. ALLOW FOR STAINLESS STEEL PERFORATED GRILLES WITH

30 DOUBLE GLAZED CURTAIN WALLING SURROUNDING EXISTING FEATURE BALLISTRADING FORMING ART DISPLAY AREA. ALLOW FOR FEATURE DISPLAY

M&E SPEC 31 ALLOW FOR SURFACE DRAINAGE TO ATRIUM FLOOR TO M&E DETAILS AND SPEC.

WITH POLYCARBONATE SECTIONS. ALLOW FOR APPROX 50% OF PANELS TO BE OPENABLE AND AUTOMACTICALLY OPERATED WITH TEMP CONTROL AND LINKED TO FIRE ALARM SYSTEM TO M&E DETAIL DESIGN. ALLOW FOR GUIDED AUTOMATED SOLAR CONTROL ROLLER BLINDS AS SILENTGLISS OR

AND LINKED TO FIRE ALARM SYSTEM TO M&E DETAIL DESIGN.

BROKEN ALUMINIUM FRAMED AND POLYCARBONATE INSULATED PANELS AS

23 INTERNAL ATRIUM FLOOR FINISH COMPRISING OF PAVING SLAB FINISH

SOLAR CONTROL ROLLER BLINDS AS SILENTGLISS OR SIMILAR.

22 PROPRIETARY COMPOSITE TIMBER FRAME CURTAIN WALLING SASH

CONTROL ROLLER BLINDS AS SILENTGLISS OR SIMILAR.

ACHIEVE TARGET ELEMENTAL U VALUE OF 1.24W/M²K

REQUIREMENTS AS PER MANUFACTURERS DETAIL.

SECONDARY STEELWORK SUPPORT SYSTEM.

INTEGRATED INSECT MESH.

AND BLOCK CONSTRUCTION TO S.E DETAIL.

12 ROOF VENTILATION LOUVRES TO EAVES AND GABLE VENTILATION, TO BE CONTINUOUS PPC ALUMINIUM VENTILATION LOUVRE PANELS AS RENSON

13 NEW FLAT ROOF STRUCTURE CONSTRUCTION COMPRISING OF HIGH PERFORMANCE POLYMERIC FULLY BONDED SINGLE PLY WATERPROOF MEMBRANE OVER 18mm WBP MARINE PLY OVER 80mm MINIMUM RIGID PIR INSULATION TO FALLS OVER SEPARATING LAYER OVER COMPOSITE

SLAB CONSTRUCTION AS COMFLOR OR SIMILAR TO S.E DETAIL SPEC.

14 EXISTING ROOF COVERING TO BE STRIPPED AND REPLACED WITH NEW PITCHED ROOF CONSTRUCTION COMPRISING OF NEW ROOF TILES AS FIBRE CEMENT TILES BY MARLEY ETERNIT SLATE BIRKDALE RANGE. ALLOW FOR 50X25mm TREATED SW TIMBER BATTENS OVER WATERPROOFING ROOFING UNDERLAY AND COUNTERBATTENS OVER 18mm WBP MARINE GRADE PLYWOOD DECKING OVER LIGHT GAUGE FAMING SPANNING BETWEEN HOT ROLLED STEEL RAFTERS TO S.E DETAIL AND SPECIFICATION. ALLOW FOR FIXINGS AND OVERLAPS AS PER MANUFACTURERS RECOMMENDATIONS FOR SEVERE EXPOSURE. COLOUR AND TYPE SUBJECT TO HERITAGE AND TOWN PLANNING APPROVAL OF SAMPLES.

SECTIONS WITH PPC ALUMINIUM LOUVERED PANELS INCLUDING INTEGRATED INSECT AND VERMIN MESH. ROOF CAPPING TO BE FORMED FROM POLYMERIC FULLY ADHERED SINGLE PLY WATERPROOF MEMBRANE OVER 18mm WBP MARINE GRADE PLY OVER LIGHT GAUGE FRAMING, TO INCLUDE

16 PPC ALUMINIUM NATURAL LOUVERED STACK VENTILATION TERMINALS WITH MOTORISED, TEMP & CO2 CONTROLLED ASSISSTED FAN AND CONTROLLABLE INSULATED INTERNAL LOUVRES, AS AIRSTRACT MECHANICAL EXTRACT TERMINAL BY PASSIVENT OR SIMILAR. ALLOW FOR 1 TERMINAL PER CLASSROOM TO SCHOOLS UPPER LEVELS, AND 1 TERMINAL PER APPROX 15M OF CORRIDOR RUNS TO UPPER LEVELS OF SCHOOLS. ALLOW FOR STEELWORK TRIMMERS FOR TERMINAL UNIT SUPPORTS AND TREATED SW TIMBER FRAMING FOR PLASTERBOARD SHAFT. ALLOW FOR CEILING LEVEL CRUILE TO SHAFT BASE

18 NEW RAISED WALKWAYS WITHIN COVERED COURTYARD TO BE AS STRUCTURAL ENGINEERS DETAILS, OF LIGHTWEIGHT CONSTRUCTION AS LIGHT GAUGE STEEL WITH COMPOSITE DECK AS HOLORIB OR SIMILAR, TIED TO HOT ROLLED STEEL STRUCTURE TO S.E DETAIL, WITH 10mm IMPACT SOUND ACOUSTIC LAYER AS ETHAFOAM, WITH 20mm T+G BOARDING AND HEAVY DUTY RESIN FLOORING FINISH. WALKWAYS TO BE UNDERLINED WITH ACOUSTIC CEILING PANELS AS ECOPHON MASTER RIGID DP SEMI CONCEALED GRID SYSTEM OR SIMILAR ACOUSTIC MODULAR LINING. ALLOW FOR PRE-FORMED SATIN STAINLESS STEEL CAPPING DETAIL TO SLAB EDGES.

15 ROOF VENTILATION TURRETS FORMED FROM LIGHT GAUGE STEEL C

PLANNING APPROVAL OF SAMPLES.

EDGE TRIMS AND DRIP FLASHING DETAILS.

CEILING LEVEL GRILLE TO SHAFT BASE.

M&E SPEC 17 LIFTS GENERALLY TO BE MACHINE ROOM-LESS, 8 PERSON AND 12 PERSON CAPACITY LIFT, PART N COMPLIANT, AS OTIS GEN2 OR SIMILAR APPROVED MANUFACTURER.

L10/650

J42/130

OR SIMILAR, TO INCLUDE INTEGRATED INSECT/VERMIN MESH.

Tel. (350) 200 74547 Fax (350) 200 74583

Email: architects@wsrm.gi Web: www.wsrm.gi

GOVERNMENT OF GIBRALTAR

DEPARTMENT OF EDUCATION

ST BERNARDS SCHOOLS

DRAWING TITLE PROPOSED SECTIONS SECTION 02

1:75@A1

G568[8-002]-sx-02-75 09.01.14

ST BERNARDS SCHOOLS

SECTION 03

CROSS SECTION THROUGH MIDDLE SCHOOL [WEST]

Scale 1:75

NOTES:

DO NOT SCALE OFF THIS DRAWING. CHECK DIMENSIONS ON SITE PRIOR TO COMMENCEMENT. THIS DRAWING IS THE COPYRIGHT OF WSRM ARCHITECTS LTD. AND MUST NOT BE COPIED OR REPRODUCED, IN PART OR IN WHOLE, WITHOUT PERMISSION OF WSRM ARCHITECTS LTD. TO BE READ IN CONJUNCTION WITH OTHER RELEVANT CONSULTANTS INFORMATION.

CONSTRUCTION NOTES

01 NEW STRUCTURAL SEPARATING FLOORS TO REPLACE EXISTING TIMBER FLOOR CONSTRUCTION, AS STRUCTURAL ENGINEERS DETAILS, COMPRISING OF COMPOSITE DECK AS COMFLOR OR SIMILAR OVER STEEL JOISTS SUPPORTED OFF PADSTONES TO S.E DETAIL, WITH 10mm IMPACT SOUND ACOUSTIC LAYER AS ETHAFOAM, WITH 20mm T+G BOARDING AND HEAVY S.E SPEC M12/100 DUTY RESIN FLOORING FINISH. SEPARATING FLOORS TO BE UNDERLINED WITH SUSPENDED EXPOSED GRID AND TILE CEILING SYSTEM GENERALLY UNLESS OTHERWISE SPECIFIED. SEPARATING FLOOR BUILD—UP TO ACHIEVE A PERFORMANCE RW RANGE LEVEL OF 55-60 (dB) . SEPARATING FLOOR BUILD-UP TO ACHIEVE A MINIMUM FIRE RATING OF 60MIN. ALLOW FOR SERVICES PENETRATIONS AND FIRE DAMPERS/COLLARS.

02 EXISTING EXTERNAL MASONRY WALLS GENERALLY (THAT ARE TO REMAIN AS EXTERNAL), TO BE RUBBED DOWN, ANY DEFECTIVE/LOOSE PLASTER TO BE HACKED OFF AND REPAIRED, PREPARED TO RECEIVE A BONDING PRIMER AGENT IN ORDER TO TAKE THROUGH COLOUR ACRYLIC RENDER WITH HIGH POLYMER CONTENT BASECOAT AND ALKALI-RESISTANT MESH REINFORCEMENT AS WEBER OR SIMILAR APPROVED PRODUCT.

O3

EXISTING EXTERNAL WALLS (REMAINING EXTERNAL) TO BE LINED INTERNALLY WITH INSULATION—BACKED HIGH IMPACT RESISTANT PLASTERBOARD, CLASS O FIRE RATED, AS GYPROC THERMALINE PIR, APPROX 38mm THICK OVERALL, WITH INTERGRAL VAPOUR MEMBRANE, TAPED AND JOINTED, FIXED THROUGH TO EXISTING WALL ON 25mm DEEP K10/100 M60/100 OMEGA RAIL FRAMING WITH COMPRESSED ROCKWOOL INFILL. OVERALL WALL CONSTRUCTION TO ACHIEVE AN ELEMENTAL 'U' VALUE OF 0.40W/M²K OR BETTER. ALL EXISTING NATURAL STONE FEATURES/SURROUNDS TO RECEIVE SPECIALIST TREATMENT, CLEANING AND PROTECTIVE SEALINGTO

SPECIALIST 04 ALLOW FOR SPECIALIST REPAIR AND REFURBISHMENT OF RETAINED HERITAGE FEATURES, METHODS AND FINISHES TO BE APPROVED BY

HERITAGE & PLANNING.

O5 EXISTING EXTERNAL WALLS WHICH ARE TO REMAIN AS INTERNAL TO BE RUBBED DOWN, ANY DEFECTIVE/LOOSE PLASTER TO BE HACKED OFF AND REPAIRED, PREPARED TO RECEIVE THROUGH COLOUR ACRYLIC RENDER WITH HIGH POLYMER CONTENT BASECOAT AND ALKALI—RESISTANT MESH REINFORCEMENT AS WEBER OR SIMILAR APPROVED PRODUCT.

REMAIN EXPOSED TO APPROVAL OF HERITAGE & PLANNING.

06 ALLOW FOR CONTINUOUS DPM TO BE TAKEN UP AND LAPPED/SEALED INTO INJECTED DPC AT MINIMUM 150MM ABOVE EXTERNAL FFL. 67 FOIL FACED RIGID INSULATION BOARDS OVER SEPARATING LAYER ON CONTINUOUS DPM AS KINGSPAN THERMAFLOOR TF70, 60mm THICK.

08 ALLOW FOR FORMING OF VENT HOLES WITHIN EXISTING WALLS INCLUDING PERFORATED STAINLESS STEEL (OR SATIN NICKEL) GRILLES WITH INTEGRATED INSECT MESH. COLÒUR, MATERIAL TBC SUBJECT TO APPROVAL

S.E SPEC OP NEW R.C RING BEAM SET INTO TOP OF EXISTING WALL TO TAKE NEW HOT ROLLED STEEL FRAME FOR NEW ROOF STRUCTURE ALL TO STRUCTURAL

10 INTERNAL PARTITIONS BETWEEN CLASSROOMS GENERALLY TO BE CONSTRUCTED FROM METAL STUD PARTITION SYSTEM BY METSEC OR SIMILAR APPROVED, CONSISTING OF METAL STUD FRAMING AS 90mm GTEC STUD AT 600mm CTS OR SIMILAR, WITH ACOUSTIC INSULATION INFILL TO ACHIEVE A SOUND INSULATION LEVEL OF 51RW OR BETTER, WITH 1 LAYER TO EITHER SIDE, OF 15mm WBP PLY TO FACILITATE WALL FIXING AND M60/100 15mm FEATHERED EDGE MEGADECO BOARD FOR SEVERE DUTY, 60 MIN RATED, TO BE TAPED JOINTED AND FILLED TO RECEIVE PAINT FINISH AS BUILT UP TO UNDERSIDE OF FLOORS /ROOF LINING ABOVE, INCLUDING DEFLECTION HEAD DETAIL, AND ACOUSTIC PROFILE FILLERS TO HEAD AND ACOUSTIC SEALANT TO BASE, GAPS AND SERVICES PENETRATIONS. FOR PENETRATIONS THROUGH FIRE COMPARTMENTATION WALLS ALLOW FOR FIRE DAMPERS/COLLARS AND FIRE RATED FILLERS. REFER TO G.A DRAWINGS FOR LOCATION OF PARTITION LINING TYPES.

11 NEW CEILINGS TO CLASSROOMS GENERALLY TO BE MF CEILING EXPOSED GRID AND TILE SYSTEM BY ARMSTRONG, CORTEGA —TEGULAR EDGE OR K40/105 SIMILAR APPROVED PRODUCT. ALLOW FOR INTEGRATED VENTILATION GRILLES FOR PASSIVENT STACK VENTILATION TO UPPER FLOOR CLASSROOMS TO NEW BUILDINGS.

12 NEW EXTENSION MONOPITCH ROOFS WITH VENTILATED VOIDS FORMED FROM KINGSPAN KS1000ZIP STANDING SEAM 45mm THICK COMPOSITE ROOF PANELS FIXED AT 1000MM CENTRES TO LIGHT GAUGE STEEL PURLINS TO SPECIALIST'S DESIGN & SPECIFICATION OVER HOT ROLLED STEEL FRAME TO S.E DETAILS AND SPEC. PURLIN DEPTH TO BE CONFIRMED BY SPECIALIST. FINISH TBC SUBJECT TO APPROVAL OF SAMPLES. ALLOW FOR PROPRIETARY MONORIDGE AND FASCIA FLASHING
DETAILS, PPC ALUMINIUM SOFFIT PANELS AND TRIMS FIXED THROUGH TO

LIGHT GAUGE STEEL SECTIONS SPANNING BETWEEN OVERHANG STUBS.

ROOF VENTILATION LOUVRES TO EAVES AND GABLE VENTILATION, TO BE CONTINUOUS PPC ALUMINIUM VENTILATION LOUVRE PANELS AS RENSON OR SIMILAR, TO INCLUDE INTEGRATED INSECT/VERMIN MESH.

14 NEW FLAT ROOF STRUCTURE CONSTRUCTION COMPRISING OF HIGH PERFORMANCE POLYMERIC FULLY BONDED SINGLE PLY WATERPROOF
MEMBRANE OVER 18mm WBP MARINE PLY OVER 80mm MINIMUM RIGID
PIR INSULATION TO FALLS OVER SEPARATING LAYER OVER COMPOSITE
SLAB CONSTRUCTION AS COMFLOR OR SIMILAR TO S.E DETAIL SPEC. J42/130

15 EXISTING ROOF COVERING TO BE STRIPPED AND REPLACED WITH NEW PITCHED ROOF CONSTRUCTION COMPRISING OF NEW ROOF TILES AS FIBRE CEMENT TILES BY MARLEY ETERNIT SLATE BIRKDALE RANGE. ALLOW FOR 50X25mm TREATED SW TIMBER BATTENS OVER WATERPROOFING ROOFING UNDERLAY AND COUNTERBATTENS OVER 18mm WBP MARINE GRADE PLYWOOD DECKING OVER LIGHT GAUGE FAMING SPANNING BETWEEN HOT ROLLED STEEL RAFTERS TO S.E DETAIL AND SPECIFICATION. ALLOW FOR FIXINGS AND OVERLAPS AS PER MANUFACTURERS
RECOMMENDATIONS FOR SEVERE EXPOSURE. COLOUR AND TYPE SUBJECT

TO HERITAGE AND TOWN PLANNING APPROVAL OF SAMPLES.

ROOF VENTILATION TURRETS FORMED FROM LIGHT GAUGE STEEL C SECTIONS WITH PPC ALUMINIUM LOUVERED PANELS INCLUDING INTEGRATED INSECT AND VERMIN MESH. ROOF CAPPING TO BE FORMED FROM POLYMERIC FULLY ADHERED SINGLE PLY WATERPROOF MEMBRANE OVER 18mm WBP MARINE GRADE PLY OVER LIGHT GAUGE FRAMING, TO INCLUDE EDGE TRIMS AND DRIP FLASHING DETAILS. L10/650 J42/130

17 PPC ALUMINIUM NATURAL LOUVERED STACK VENTILATION TERMINALS WITH MOTORISED, TEMP & CO2 CONTROLLED ASSISSTED FAN AND CONTROLLABLE INSULATED INTERNAL LOUVRES, AS AIRSTRACT MECHANICAL EXTRACT TERMINAL BY PASSIVENT OR SIMILAR. 

NEW WINDOWS GENERALLY IN EXISTING BUILDING TO BE PROPRIETARY, COMPOSITE TIMBER FRAME CURTAIN WALLING TILT & TURN WINDOWS AND FIXED PANE DOUBLE GLAZED WINDOWS BY MARVIN OR SIMILAR SYSTEM. ALLOW FOR FRAMED, GUIDED AUTOMATED SOLAR CONTROL ROLLER BLINDS L10/--

> 19 FEATURE ATRIUM ROOF COVERING, CENTRE—OPENING SLIDING THERMALLY BROKEN ALUMINIUM FRAMED AND POLYCARBONATE INSULATED PANELS AS 'OPENAIRE' OR SIMILAR, AUTOMACTICALLY OPERATED WITH TEMP CONTROL AND LINKED TO FIRE ALARM SYSTEM TO M&E DETAIL DESIGN.

20 DOUBLE GLAZED CURTAIN WALLING SURROUNDING EXISTING FEATURE BALUSTRADING FORMING ART DISPLAY AREA. ALLOW FOR FEATURE DISPLAY

S.E SPEC J40/142

NEW GROUND BEARING, STEEL REINFORCED CONCRETE SLAB TO STRUCTURAL ENGINEERS DETAIL AND SPECIFICATION OVER CONTINUOUS DPM OVER BLINDING AND HARDCORE. DPM TO BE TAKEN UP EDGES OF J40/142 FLOOR SLAB AND TUCKED IN TO BASE OF THERMAL CLAY BLOCK WALL.

FLOOR FINISH OVER MESH REINFORCED FLOATING SCREED OVER 25mm THICK RIGID INSULATION LAYER AS KINGSPAN THERMAFLOOR TF70 OR M40/110 SIMILAR APPROVED.

NEW EXTENSION WALLS GENERALLY TO BE CONSTRUCTED FROM 240mm CERAMIC THERMAL BLOCK AS TERMOARCILLA OR SIMILAR, WITH EXTERNAL MECHANICALLY FIXED INSULATED RENDER SYSTEM AS WEBERTHERM XM OR SIMILAR APPROVED (INSULATION THICKNESS TBC BY MANUFACTURER F10/110 M21/210 SUBJECT TO PROOF OF ELEMENTAL 'U'VALUE TARGET). CERAMIC BLOCKS TO BE LINED INTERNALLY WITH HIGH IMPACT LINING AS 1 LAYER 15mm MEGADECO BOARD BY LAFARGE OR SIMILAR APPROVED PRODUCT OVER K10/100 LIGHT-GAUGE STEEL OMEGA PROFILE FRAMING APPROX 25mm DEEP MECHANICALLY FIXED ONTO CERAMIC THERMAL BLOCK. OVERALL WALL CONSTRUCTION TO ACHIEVE AN ELEMENTAL 'U' VALUE OF 0.35W/m2K.

24 FLAT ROOF CONSTRUCTION COMPRISING OF CONTINUOUS SINGLE PLY WATERPROOF MEMBRANE OVER 18mm MARINE GRADE WBP PLYWOOD BASE FIXED THROUGH TREATED SW TIMBER NOGGINS TO ACHIEVE 1:80 FALLS OVER LIGHT GAUGE STEEL PURLINS SPANNING BETWEEN HOT ROLLED STEEL ROOF JOISTS. ROOF STRUCTURE TO BE UNDERDRAWN WITH VAPOUR BARRIER AND 18mm WBP MARINE GRADE PLYWOOD LAYER, WITH 150mm ROCKWOOL QUILT INFILL INSULATION.

S.E SPEC 25 FEATURE PFC TO EDGE OF FLAT ROOF

FOR CONSTRUCTION

rev | date | amendments

A 31.01.2014 ISSUED FOR CONSTRUCTION B 11.04.2014 D+W REFERENCES ADDED

WSRM architects

1.2.20 EUROTOWERS **GIBRALTAR** Tel. (350) 200 74547 Fax (350) 200 74583


Email: architects@wsrm.gi Web: www.wsrm.gi

GOVERNMENT OF GIBRALTAR DEPARTMENT OF EDUCATION

ST BERNARDS SCHOOLS

RAWING TITLE PROPOSED SECTIONS SECTION 03

1:75@A1 G568[8-003]-SX-03-75 09.01.14

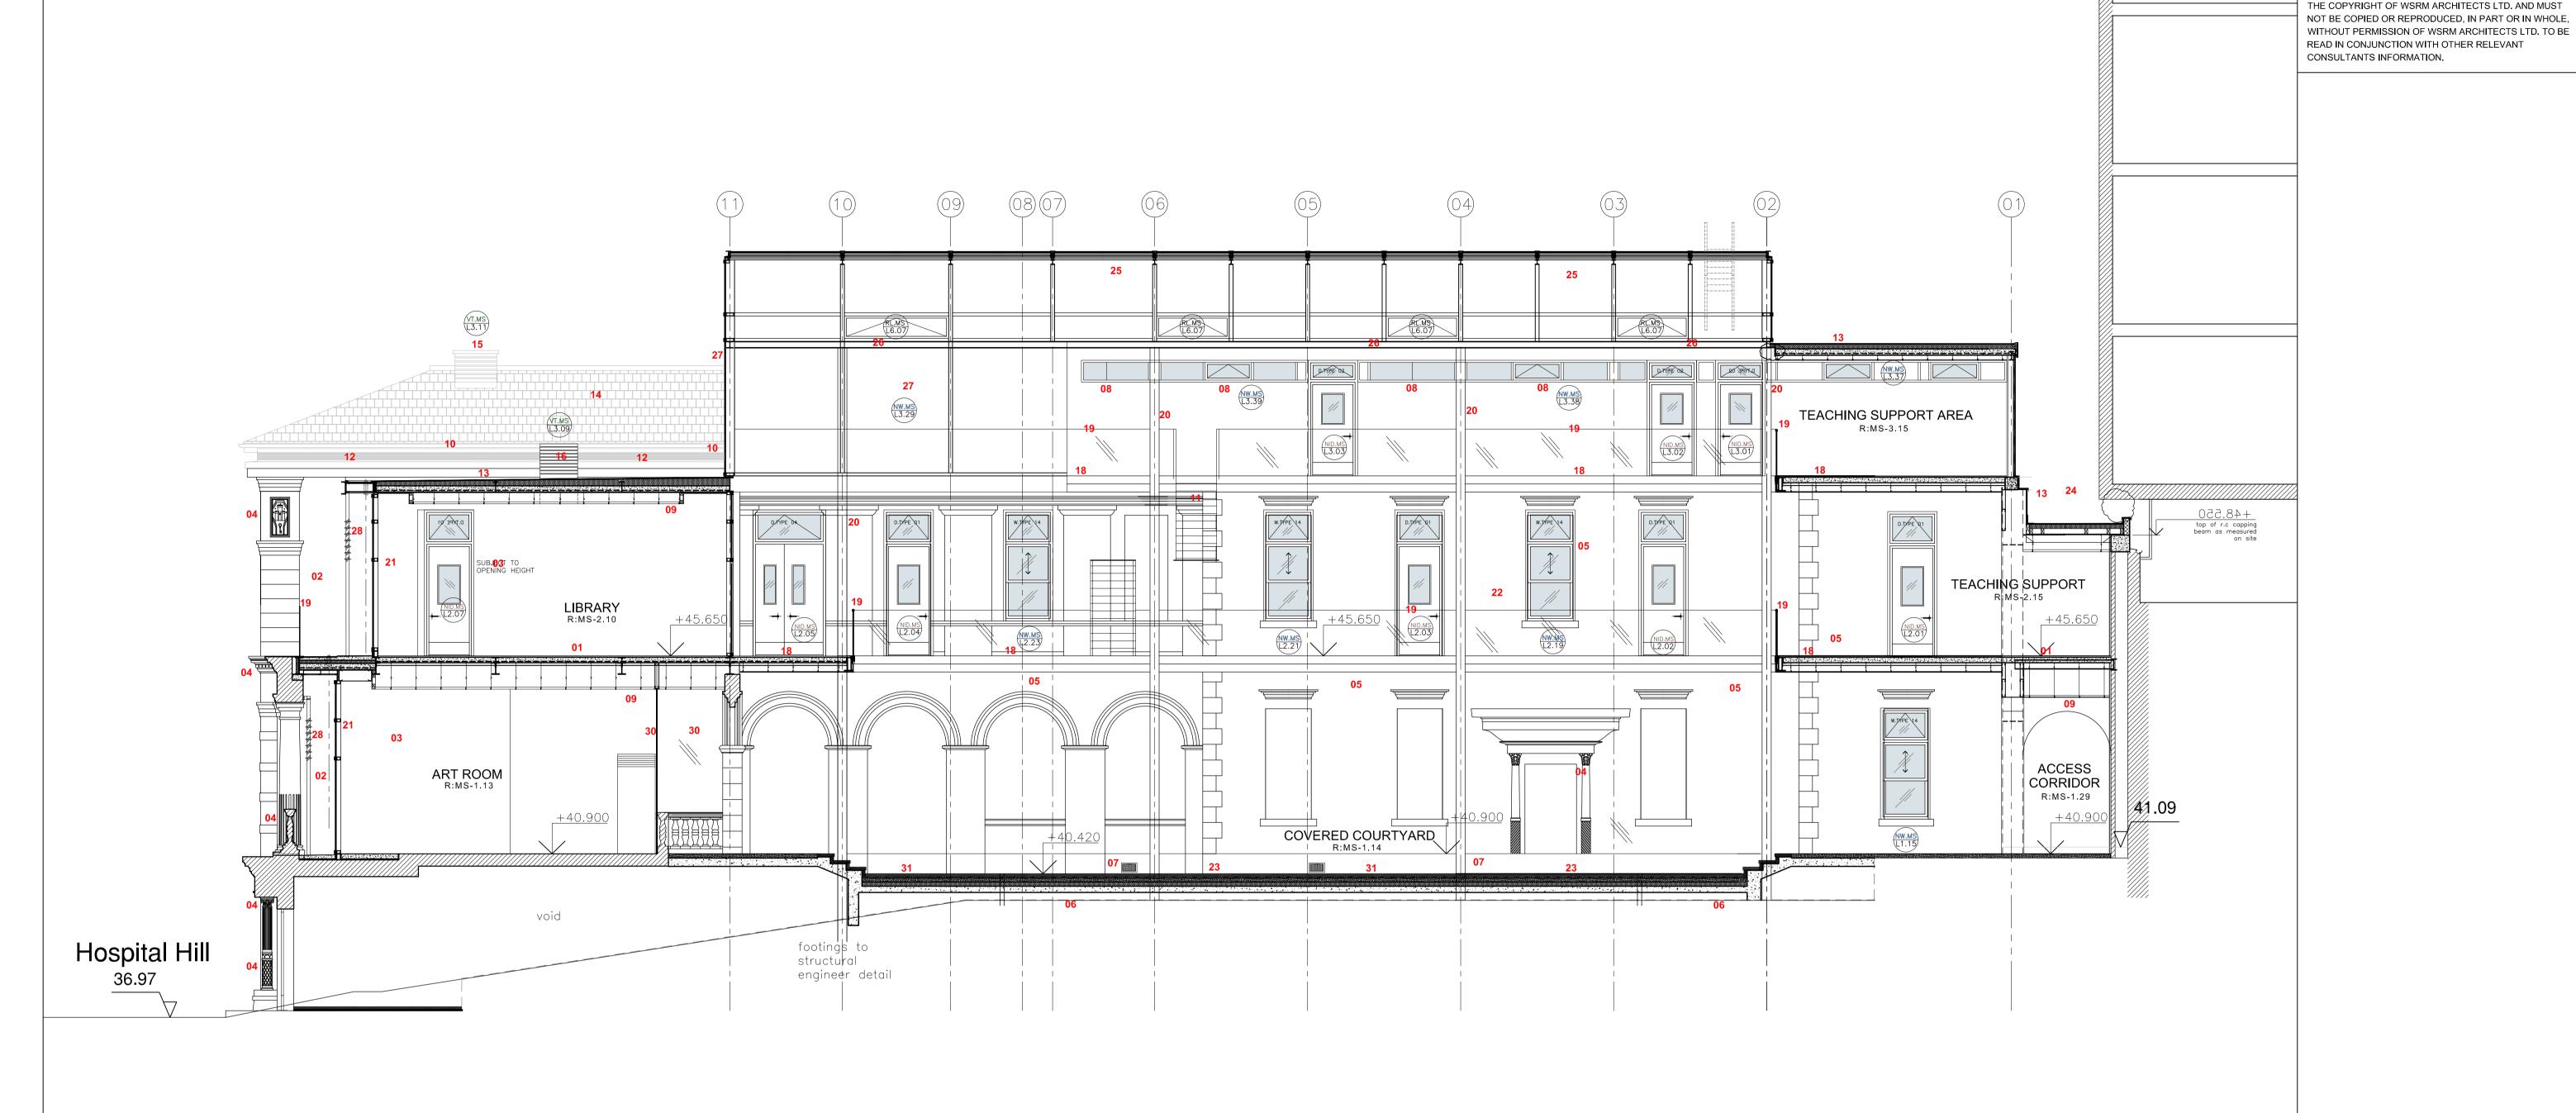

ST BERNARDS SCHOOLS **SECTION 04**

LONGITUDONAL SECTION THROUGH MIDDLE SCHOOL ATRIUM SPACE Scale 1:75

NBS REF CONSTRUCTION NOTES

01 NEW STRUCTURAL SEPARATING FLOORS TO REPLACE EXISTING TIMBER FLOOR CONSTRUCTION, AS STRUCTURAL ENGINEERS DETAILS, COMPRISING OF COMPOSITE DECK AS COMFLOR OR SIMILAR OVER STEEL JOISTS S.E SPEC SUPPORTED OFF PADSTONES TO S.E DETAIL, WITH 10mm IMPACT SOUND ACOUSTIC LAYER AS ETHAFOAM, WITH 20mm T+G BOARDING AND HEAVY M12/100 DUTY RESIN FLOORING FINISH. SEPARATING FLOORS TO BE UNDERLINED WITH SUSPENDED EXPOSED GRID AND TILE CEILING SYSTEM GENERALLY UNLESS OTHERWISE SPECIFIED. SEPARATING FLOOR BUILD-UP TO ACHIEVE A PERFORMANCE RW RANGE LEVEL OF 55-60 (dB) . SEPARATING FLOOR BUILD-UP TO ACHIEVE A MINIMUM FIRE RATING OF 60MIN. ALLOW FOR SERVICES PENETRATIONS AND FIRE DAMPERS/COLLARS.

02 EXISTING EXTERNAL MASONRY WALLS GENERALLY (THAT ARE TO REMAIN M20/160

AS EXTERNAL), TO BE RUBBED DOWN, ANY DEFECTIVE/LOOSE PLASTER TO BE HACKED OFF AND REPAIRED, PREPARED TO RECEIVE A BONDING PRIMER AGENT IN ORDER TO TAKE THROUGH COLOUR ACRYLIC RENDER WITH HIGH POLYMER CONTENT BASECOAT AND ALKALI-RESISTANT MESH REINFORCEMENT AS WEBER OR SIMILAR APPROVED PRODUCT.

03 EXISTING EXTERNAL WALLS (REMAINING EXTERNAL) TO BE LINED INTERNALLY WITH INSULATION—BACKED HIGH IMPACT RESISTANT PLASTERBOARD, CLASS O FIRE RATED, AS GYPROC THERMALINE PIR, K10/100

M60/100

APPROX 38mm THICK OVERALL, WITH INTERGRAL VAPOUR MEMBRANE, TAPED AND JOINTED, FIXED THROUGH TO EXISTING WALL ON 25mm DEEP OMEGA RAIL FRAMING WITH COMPRESSED ROCKWOOL INFILL. OVERALL WALL CONSTRUCTION TO ACHIEVE AN ELEMENTAL 'U' VALUE OF 0.40W/M2K OR BETTER. ALL EXISTING NATURAL STONE FEATURES/SURROUNDS TO RECEIVE SPECIALIST TREATMENT, CLEANING AND PROTECTIVE SEALING TO REMAIN EXPOSED TO APPROVAL OF HERITAGE & PLANNING.

04 ALLOW FOR SPECIALIST REPAIR AND REFURBISHMENT OF RETAINED SPECIALIST HERITAGE FEATURES, METHODS AND FINISHES TO BE APPROVED BY HERITAGE & PLANNING.

05 EXISTING EXTERNAL WALLS WHICH ARE TO REMAIN AS INTERNAL TO BE M20/160

RUBBED DOWN, ANY DEFECTIVE/LOOSE PLASTER TO BE HACKED OFF AND REPAIRED, PREPARED TO RECEIVE THROUGH COLOUR ACRYLIC RENDER WITH HIGH POLYMER CONTENT BASECOAT AND ALKALI-RESISTANT MESH REINFORCEMENT AS WEBER OR SIMILAR APPROVED PRODUCT.

C45/220 Of ALLOW FOR CONTINUOUS DPM TO BE TAKEN UP AND LAPPED/SEALED INTO INJECTED DPC AT MINIMUM 150MM ABOVE EXTERNAL FFL.

07 ALLOW FOR FORMING OF VENT HOLES WITHIN EXISTING WALLS INCLUDING PERFORATED STAINLESS STEEL (OR SATIN NICKEL) GRILLES WITH INTEGRATED INSECT MESH. COLOUR, MATERIAL TBC SUBJECT TO APPROVAL

08 HIGH LEVEL DOUBLE GLAZED ALUMINIUM FRAMED OPENABLE AND FIXED CLERESTORY WINDOWS TO AID NATURAL VENTILATION INCLUDING INTEGRATED AUTOMATED DIM-OUT BLINDS AS SILENTGLISS OR SIMILAR

09 NEW CEILINGS GENERALLY TO BE MF CEILING EXPOSED GRID AND TILE SYSTEM BY ARMSTRONG, CORTEGA —TEGULAR EDGE OR SIMILAR APPROVED PRODUCT. REFER TO G.AS FOR CEILING TYPES.
ALLOW FOR INTEGRATED VENTILATION GRILLES FOR PASSIVENT STACK VENTILATION TO UPPER FLOOR CLASSROOMS TO NEW BUILDINGS. 10 ALLOW FOR DEEP-FLOW PPC ALUMINIUM GUTTERS AND DOWNPIPES WITH CONCEALED JOINTS AND WALL FIXINGS AS ALUMASC OR SIMILAR

NBS REF CONSTRUCTION NOTES

11 NEW FEATURE CIRCULATION STAIRWAYS SPANNING BETWEEN WALKWAYS IN ATRIUM TO BE CONSTRUCTED IN STRUCTURAL STEEL STRINGERS TO S.E.

SPEC WITH FRAMELESS GLAZED BALUSTRADING STAINLESS STEEL CAPRAILS, WITH CONCEALED SUPPORT ANGLES, SUPPORTING TREADS TO BE FORMED FROM 42mm THICK SOLID HARDWOOD TREATED AND FINISHED IN CLEAR MATT LAQUER, TO WITHSTAND LOADS TO S.E CALCULATION, WITH 3No. 2X5mm SS ANTI-SLIP INSERT STRIPS TO EACH TREAD. OVERALL STAIR AND BALUSTRADING DESIGN TO COMPLY WITH APPROVED DOCUMENTS
PART K AND PART N OF UK BUILDING REGULATIONS. ALLOW FOR FACTORY
APPLIED PAINTING OF STRUCTURAL STEEL WITH SMOOTH FINISH

12 ROOF VENTILATION LOUVRES TO EAVES AND GABLE VENTILATION, TO BE CONTINUOUS PPC ALUMINIUM VENTILATION LOUVRE PANELS AS RENSON L10/650 OR SIMILAR, TO INCLUDE INTEGRATED INSECT/VERMIN MESH. 13 NEW FLAT ROOF STRUCTURE CONSTRUCTION COMPRISING OF HIGH

J42/130

PERFORMANCE POLYMERIC FULLY BONDED SINGLE PLY WATERPROOF MEMBRANE OVER 18mm WBP MARINE PLY OVER 80mm MINIMUM RIGID PIR INSULATION TO FALLS OVER SEPARATING LAYER OVER COMPOSITE SLAB CONSTRUCTION AS COMFLOR OR SIMILAR TO S.E DETAIL SPEC. 14 EXISTING ROOF COVERING TO BE STRIPPED AND REPLACED WITH NEW PITCHED ROOF CONSTRUCTION COMPRISING OF NEW ROOF TILES AS FIBRE CEMENT TILES BY MARLEY ETERNIT SLATE BIRKDALE RANGE. ALLOW FOR 50X25mm TREATED SW TIMBER BATTENS OVER WATERPROOFING ROOFING LINDERLAY AND COLUNTERBATTENS OVER 18mm WBP MARINE CRADE SUXZSMM TREATED SW TIMBER BATTENS OVER WATERPROOFING ROOFING UNDERLAY AND COUNTERBATTENS OVER 18mm WBP MARINE GRADE PLYWOOD DECKING OVER LIGHT GAUGE FAMING SPANNING BETWEEN HOT ROLLED STEEL RAFTERS TO S.E DETAIL AND SPECIFICATION. ALLOW FOR FIXINGS AND OVERLAPS AS PER MANUFACTURERS RECOMMENDATIONS FOR SEVERE EXPOSURE. COLOUR AND TYPE SUBJECT TO HERITAGE AND TOWN PLANNING APPROVAL OF SAMPLES.

L10/650

L10/650

J42/130

The property of the

16 PPC ALUMINIUM NATURAL LOUVERED STACK VENTILATION TERMINALS WITH MOTORISED, TEMP & CO2 CONTROLLED ASSISSTED FAN AND CONTROLLABLE INSULATED INTERNAL LOUVERS, AS AIRSTRACT MECHANICAL EXTRACT TERMINAL BY PASSIVENT OR SIMILAR. ALLOW FOR 1 TERMINAL DEPORT OF THE PROPERTY O PER CLASSROOM TO SCHOOLS UPPER LEVELS, AND 1 TERMINAL PER APPROX 15M OF CORRIDOR RUNS TO UPPER LEVELS OF SCHOOLS.

ALLOW FOR STEELWORK TRIMMERS FOR TERMINAL UNIT SUPPORTS AND TREATED SW TIMBER FRAMING FOR PLASTERBOARD SHAFT. ALLOW FOR

M&E SPEC 17 LIFTS GENERALLY TO BE MACHINE ROOM-LESS, 8 PERSON AND 12 PERSON CAPACITY LIFT, PART N COMPLIANT, AS OTIS GEN2 OR SIMILAR APPROVED MANUFACTURER.

CEILING LEVEL GRILLE TO SHAFT BASE.

18 NEW RAISED WALKWAYS WITHIN COVERED COURTYARD TO BE AS STRUCTURAL ENGINEERS DETAILS, OF LIGHTWEIGHT CONSTRUCTION AS S.E. SPEC LIGHT GAUGE STEEL WITH COMPOSITE DECK AS HOLORIB OR SIMILAR, TIED TO HOT ROLLED STEEL STRUCTURE TO S.E DETAIL, WITH 10mm IMPACT SOUND ACOUSTIC LAYER AS ETHAFOAM, WITH 20mm T+G BOARDING AND HEAVY DUTY RESIN FLOORING FINISH. WALKWAYS TO BE UNDERLINED WITH ACOUSTIC CEILING PANELS AS ECOPHON MASTER RIGID DP SEMI CONCEALED GRID SYSTEM OR SIMILAR ACOUSTIC MODULAR LINING. ALLOW FOR PRE-FORMED SATIN STAINLESS STEEL CAPPING DETAIL TO SLAB

NBS REF CONSTRUCTION NOTES

SHOE AND CAPRAILS.

19 BALUSTRADING TO BE FRAMELESS GLAZED PANELS AS 'Q-RAILING EASY GLASS SYSTEM' OR SIMILAR, IN LAMINATED SAFETY GLAZING TO COMPLY WITH UK APPROVED DOC PART N AND PART K OF THE BUILDING REGULATIONS, WITH CONTINUOUS PROPRIETARY STAINLESS STEEL FIXING

20 CIRCULAR STEEL COLUMNS TO STRUCTURAL ENGINEERS DETAIL DESIGN TO BE FINISHED WITH FACTORY APPLIED PAINTING IN SMOOTH FINISH INTUMESCENT COATING AS NULLIFIRE OR SIMILAR. 21 PROPRIETARY, THERMALLY BROKEN ALUMINIUM CURTAIN WALLING TILT &

TURN AND FIXED PANE DOUBLE GLAZED WINDOWS BY TECHNAL REF TECHNAL REF MX OR MC SYSTEM. ALLOW FOR FRAMED, GUIDED AUTOMATED SOLAR CONTROL ROLLER BLINDS AS SILENTGLISS OR SIMILAR. 22 PROPRIETARY COMPOSITE TIMBER FRAME CURTAIN WALLING SASH WINDOWS AND FIXED PANE DOUBLE GLAZED WINDOWS BY MARVIN OR SIMILAR SYSTEM. ALLOW FOR FRAMED, GUIDED AUTOMATED SOLAR

23 INTERNAL ATRIUM FLOOR FINISH COMPRISING OF PAVING SLAB FINISH OVER 100mm SAND CEMENT SCREED WITH EMBEDDED CHILLING/HEATING Q24/110

PIPEWORK TO M&E DESIGN OVER 100mm NON-COMPRESSIBLE INSULATION AS KINGSPAN THERMAFLOOR TF70 OR SIMILAR OVER SUSPENDED BEAM

CONTROL ROLLER BLINDS AS SILENTGLISS OR SIMILAR.

AND BLOCK CONSTRUCTION TO S.E DETAIL.

24 VITRAL SKY VISION FIXED ROOF GLAZING SKYLIGHTS FOR FLAT ROOFS, OR SIMILAR APPROVED SYSTEM, COMPOSED OF MODULAR SKYLIGHT UNIT WITH INTEGRATED KERB UPSTAND, HERMETICALLY SEALED DOUBLE GLAZED UNIT WITH LOW E, IMPACT RESISTANT, SOLAR CONTROL GLAZING. OUTER FACE OF EXTERNAL PANEL TO BE SCREEN PRINTED IN PATTERN/COLOUR TBC FRAMING TO BE PPC EXTRUDED ALUMINIUM, THERMALLY BROKEN, TO ACHIEVE TARGET ELEMENTAL U VALUE OF 1.24W/M2K.

25 FEATURE ATRIUM ROOF COVERING, CENTRE-OPENING SLIDING THERMALLY BROKEN ALUMINIUM FRAMED AND POLYCARBONATE INSULATED PANELS AS 'OPENAIRE' OR SIMILAR, AUTOMACTICALLY OPERATED WITH TEMP CONTROL AND LINKED TO FIRE ALARM SYSTEM TO M&E DETAIL DESIGN.

ROOFLIGHT TO UPPER CIRCULATION AREA OF PRIMARY SCHOOL AS SILENTGLISS OR SIMILAR. ALLOW FOR SUPPORT / CABLE/ RAIL REQUIREMENTS AS PER MANUFACTURERS DETAIL.

26 ALLOW FOR FEATURE MOTORISED SOLAR SHADING BLINDS TO UNDERSIDE OF RETRACTABLE ROOF OVER COURTYARD AND TO CONTINUOUS

27 FEATURE ATRIUM VERTICAL PANELS IN THERMALLY BROKEN ALUMINIUM 7 FEATURE AIRIUM VERTICAL PANELS IN THERMALLY BROKEN ALUMINIUM WITH POLYCARBONATE SECTIONS. ALLOW FOR APPROX 50% OF PANELS TO BE OPENABLE AND AUTOMACTICALLY OPERATED WITH TEMP CONTROL AND LINKED TO FIRE ALARM SYSTEM TO M&E DETAIL DESIGN. ALLOW FOR GUIDED AUTOMATED SOLAR CONTROL ROLLER BLINDS AS SILENTGLISS OR

28 EXTERNAL AUTOMATED CONTROLLABLE BRISE SOLIEL AS TECHNAL SUNEAL OR SIMILAR EXTERNAL PPC ALUMINIUM LOUVRE SYSTEM. ALLOW FOR SECONDARY STEELWORK SUPPORT SYSTEM.

DOUBLE GLAZED CURTAIN WALLING SURROUNDING EXISTING FEATURE BALUSTRADING FORMING ART DISPLAY AREA. ALLOW FOR FEATURE DISPLAY LIGHTING. 31 ALLOW FOR SURFACE DRAINAGE TO ATRIUM FLOOR TO M&E DETAILS AND M&E SPEC.

29 EXISTING VENT HOLES TO BE RETAINED TO AID IN NATURAL VENTILATION STRATEGY, ALLOW FOR STAINLESS STEEL PERFORATED GRILLES WITH

INTEGRATED INSECT MESH.

FOR CONSTRUCTION

rev | date | amendments

NOTES:

DO NOT SCALE OFF THIS DRAWING. CHECK DIMENSIONS ON SITE PRIOR TO COMMENCEMENT. THIS DRAWING IS

A 31.01.2014 ISSUED FOR CONSTRUCTION B 11.04.2014 D+W REFERENCES ADDED

C 02.05.2014 D+W ADDITIONAL REFS ADDED

WSRM architects

1.2.20 EUROTOWERS PO BOX 474 GIBRALTAR

Tel. (350) 200 74547 Fax (350) 200 74583 Email: architects@wsrm.gi Web: www.wsrm.gi

GOVERNMENT OF GIBRALTAR


DEPARTMENT OF EDUCATION


ST BERNARDS SCHOOLS

DRAWING TITLE PROPOSED SECTIONS SECTION 04

1:75@A1 23.01.14

G568[8-004]-sx-04-75

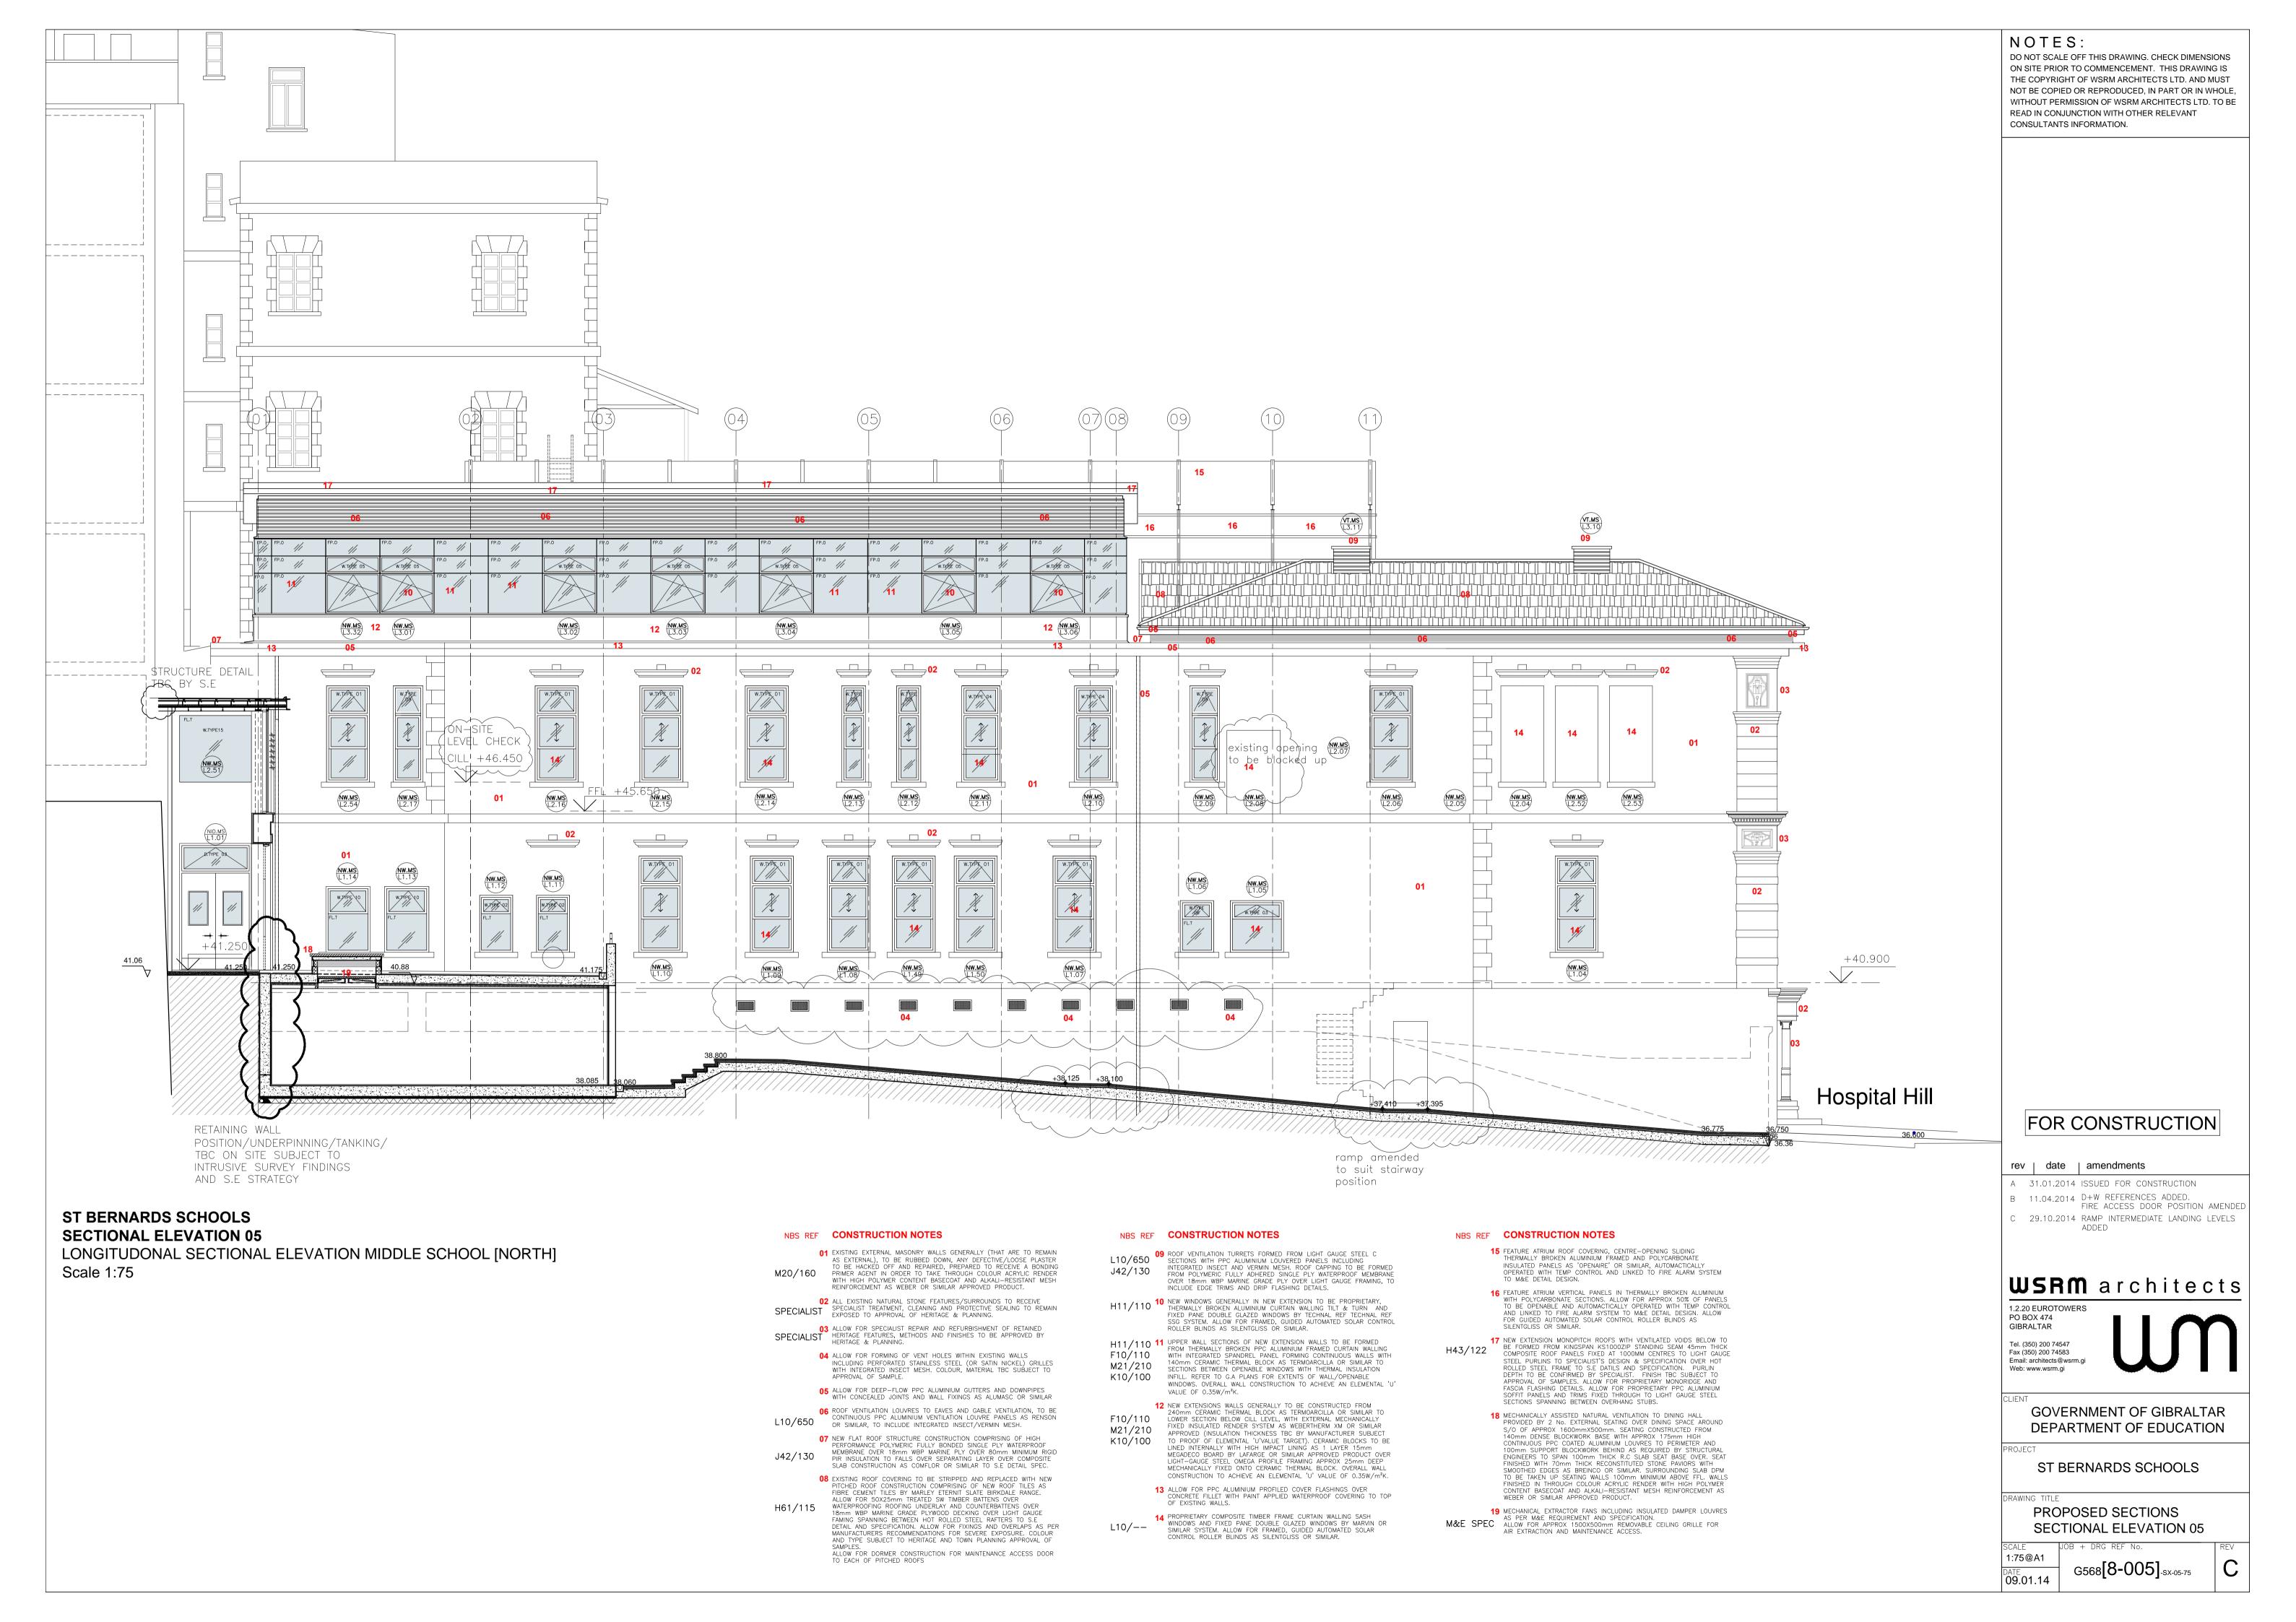

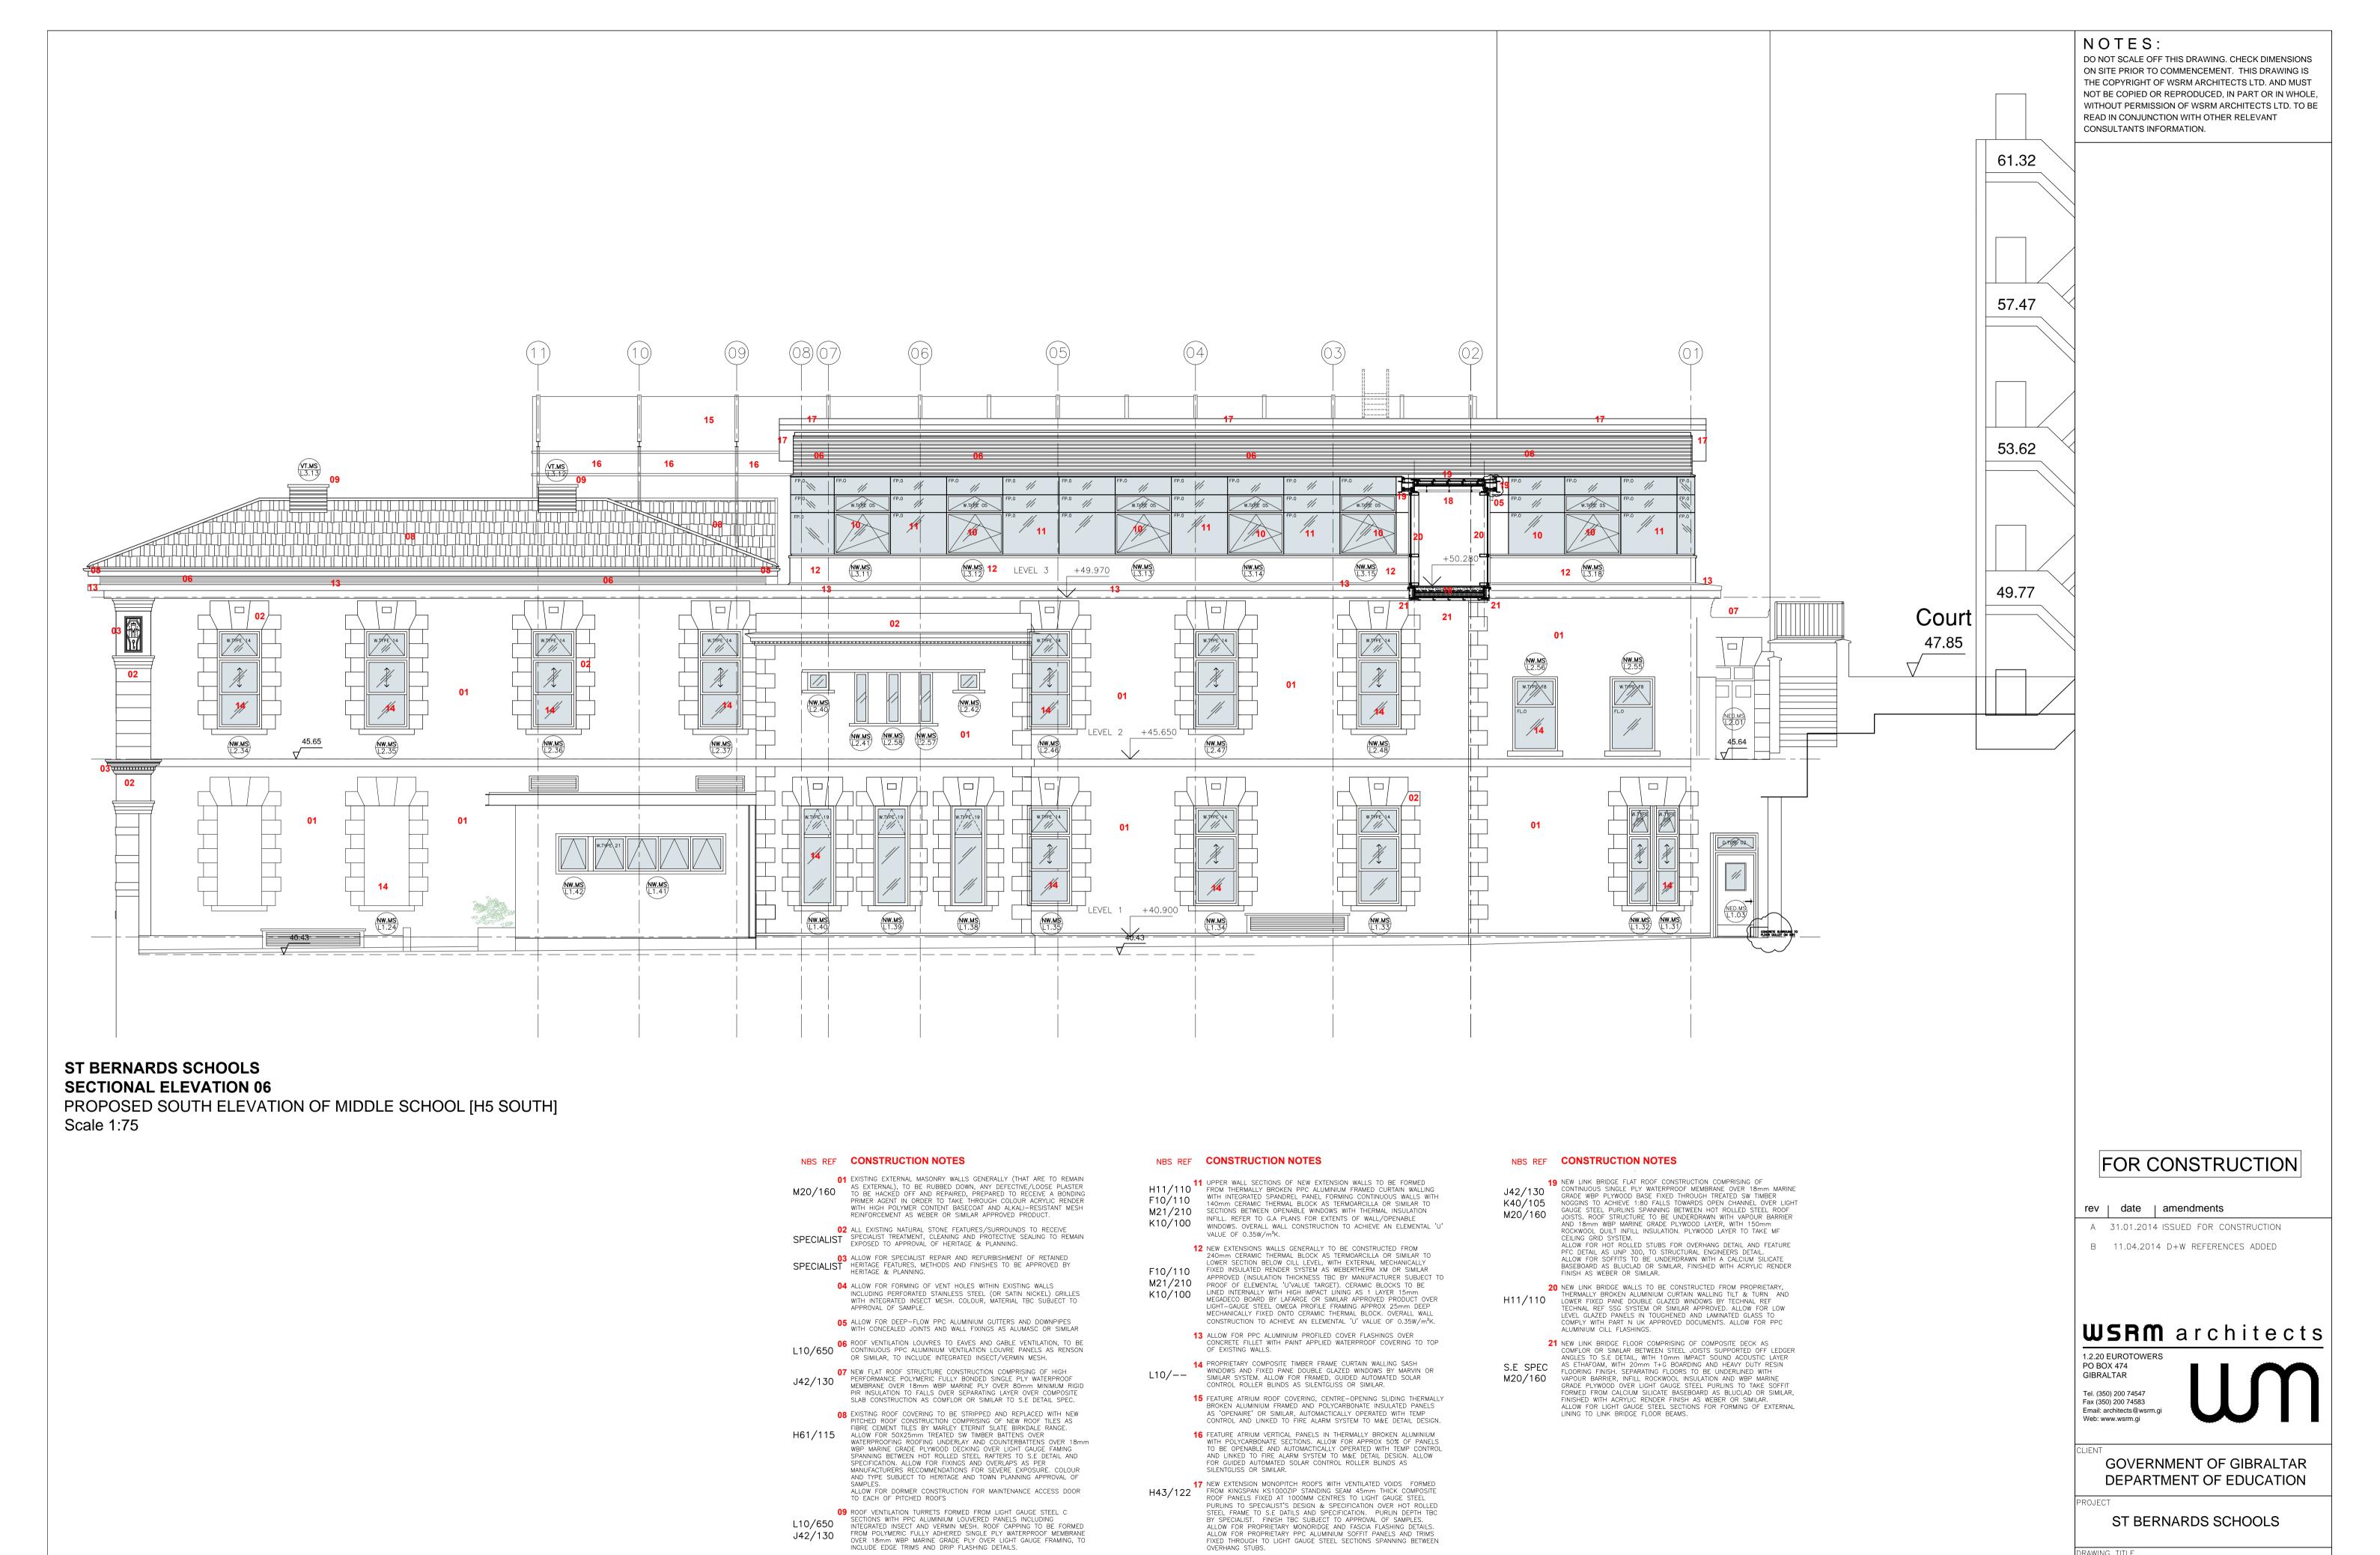

S.E SPEC 18 NEW LINK BRIDGE BETWEEN H5 AND H7 BUILDINGS TO BE FORMED FROM FRAME CONSISTING OF HOT ROLLED STEEL BEAMS WITH LIGHT GAUGE STEEL PURLINS/C SECTIONS SPANNING BETWEEN BEAMS.

10 NEW WINDOWS GENERALLY IN NEW EXTENSION TO BE PROPRIETARY,

H11/110

HH 1/110

HI 1/11

SECTIONAL ELEVATION 06 1:75@A1 G568[8-006]-SX-06-75 09.01.14

PROPOSED ELES/SECTIONS

DRAWING TITLE



DO NOT SCALE OFF THIS DRAWING. CHECK DIMENSIONS ON SITE PRIOR TO COMMENCEMENT. THIS DRAWING IS THE COPYRIGHT OF WSRM ARCHITECTS LTD. AND MUST NOT BE COPIED OR REPRODUCED, IN PART OR IN WHOLE, WITHOUT PERMISSION OF WSRM ARCHITECTS LTD. TO BE READ IN CONJUNCTION WITH OTHER RELEVANT

FOR CONSTRUCTION

rev | date | amendments

A 31.01.2014 ISSUED FOR CONSTRUCTION


B 11.04.2014 D+W REFERENCES ADDED


WSRM architects

GOVERNMENT OF GIBRALTAR DEPARTMENT OF EDUCATION

PROPOSED SECTIONS/ ELEVATIONS SECTIONAL ELEVATION 07 [EAST]

G568[8-007]-SX-07-75

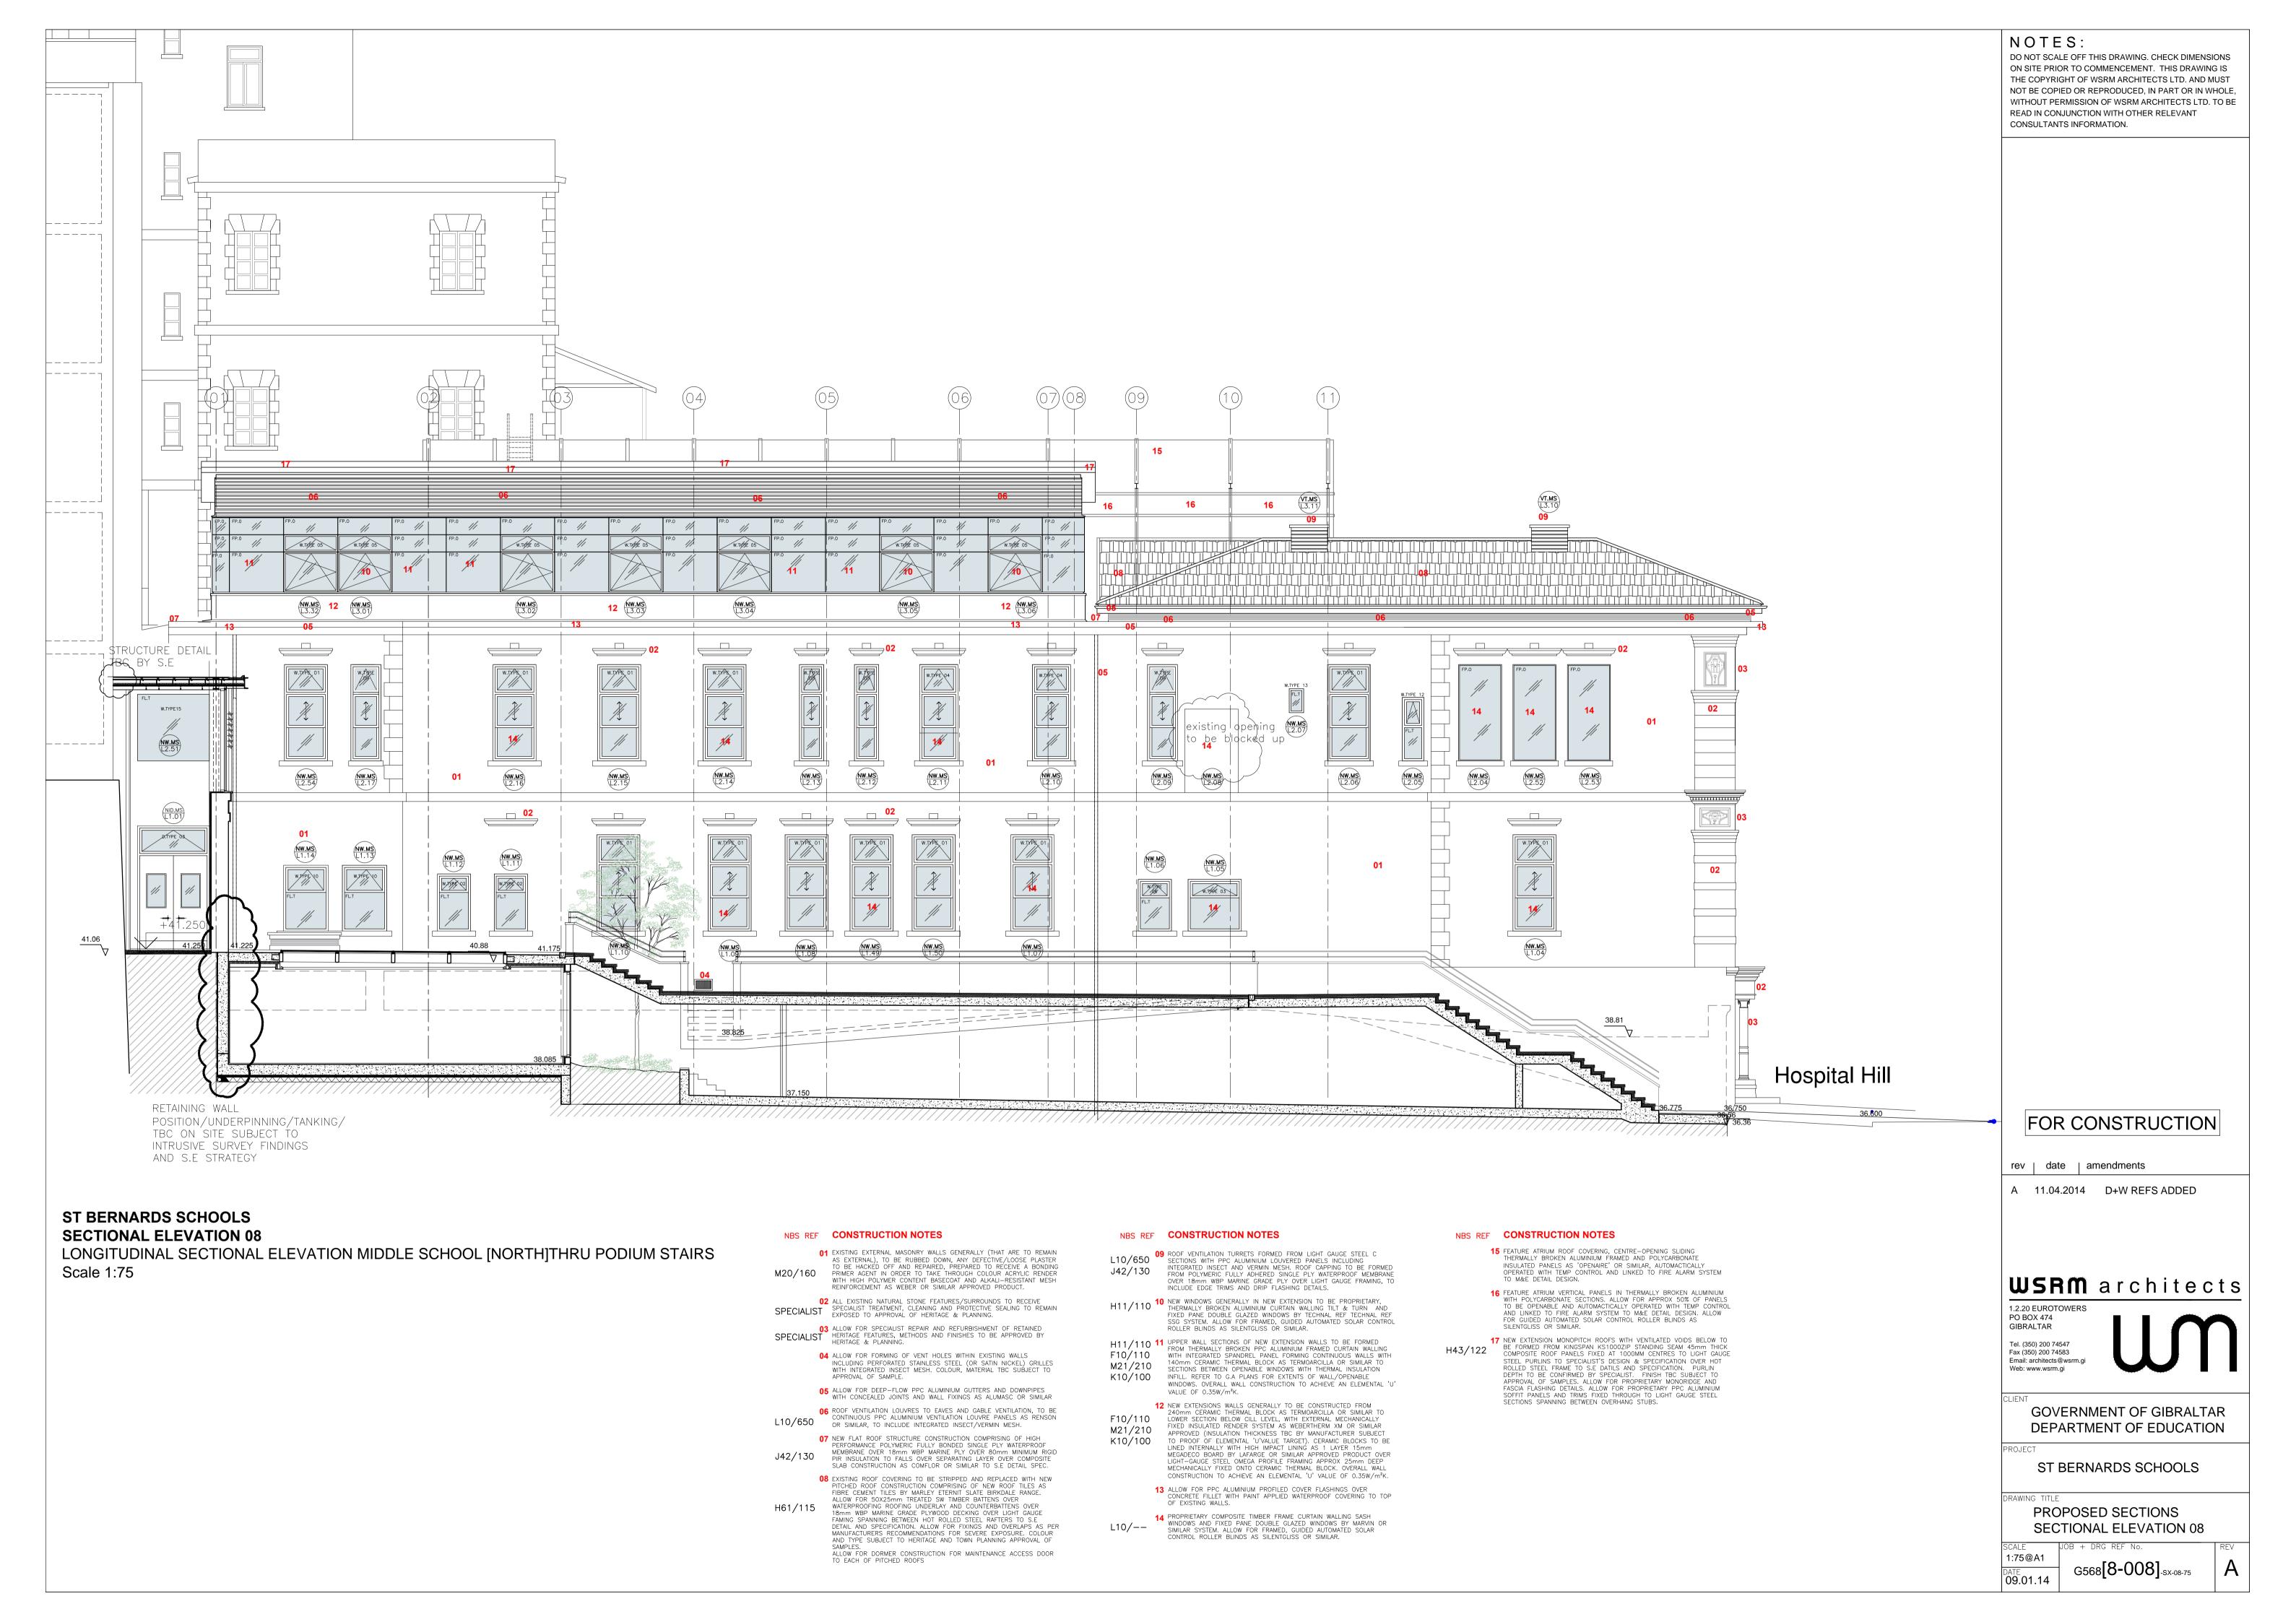

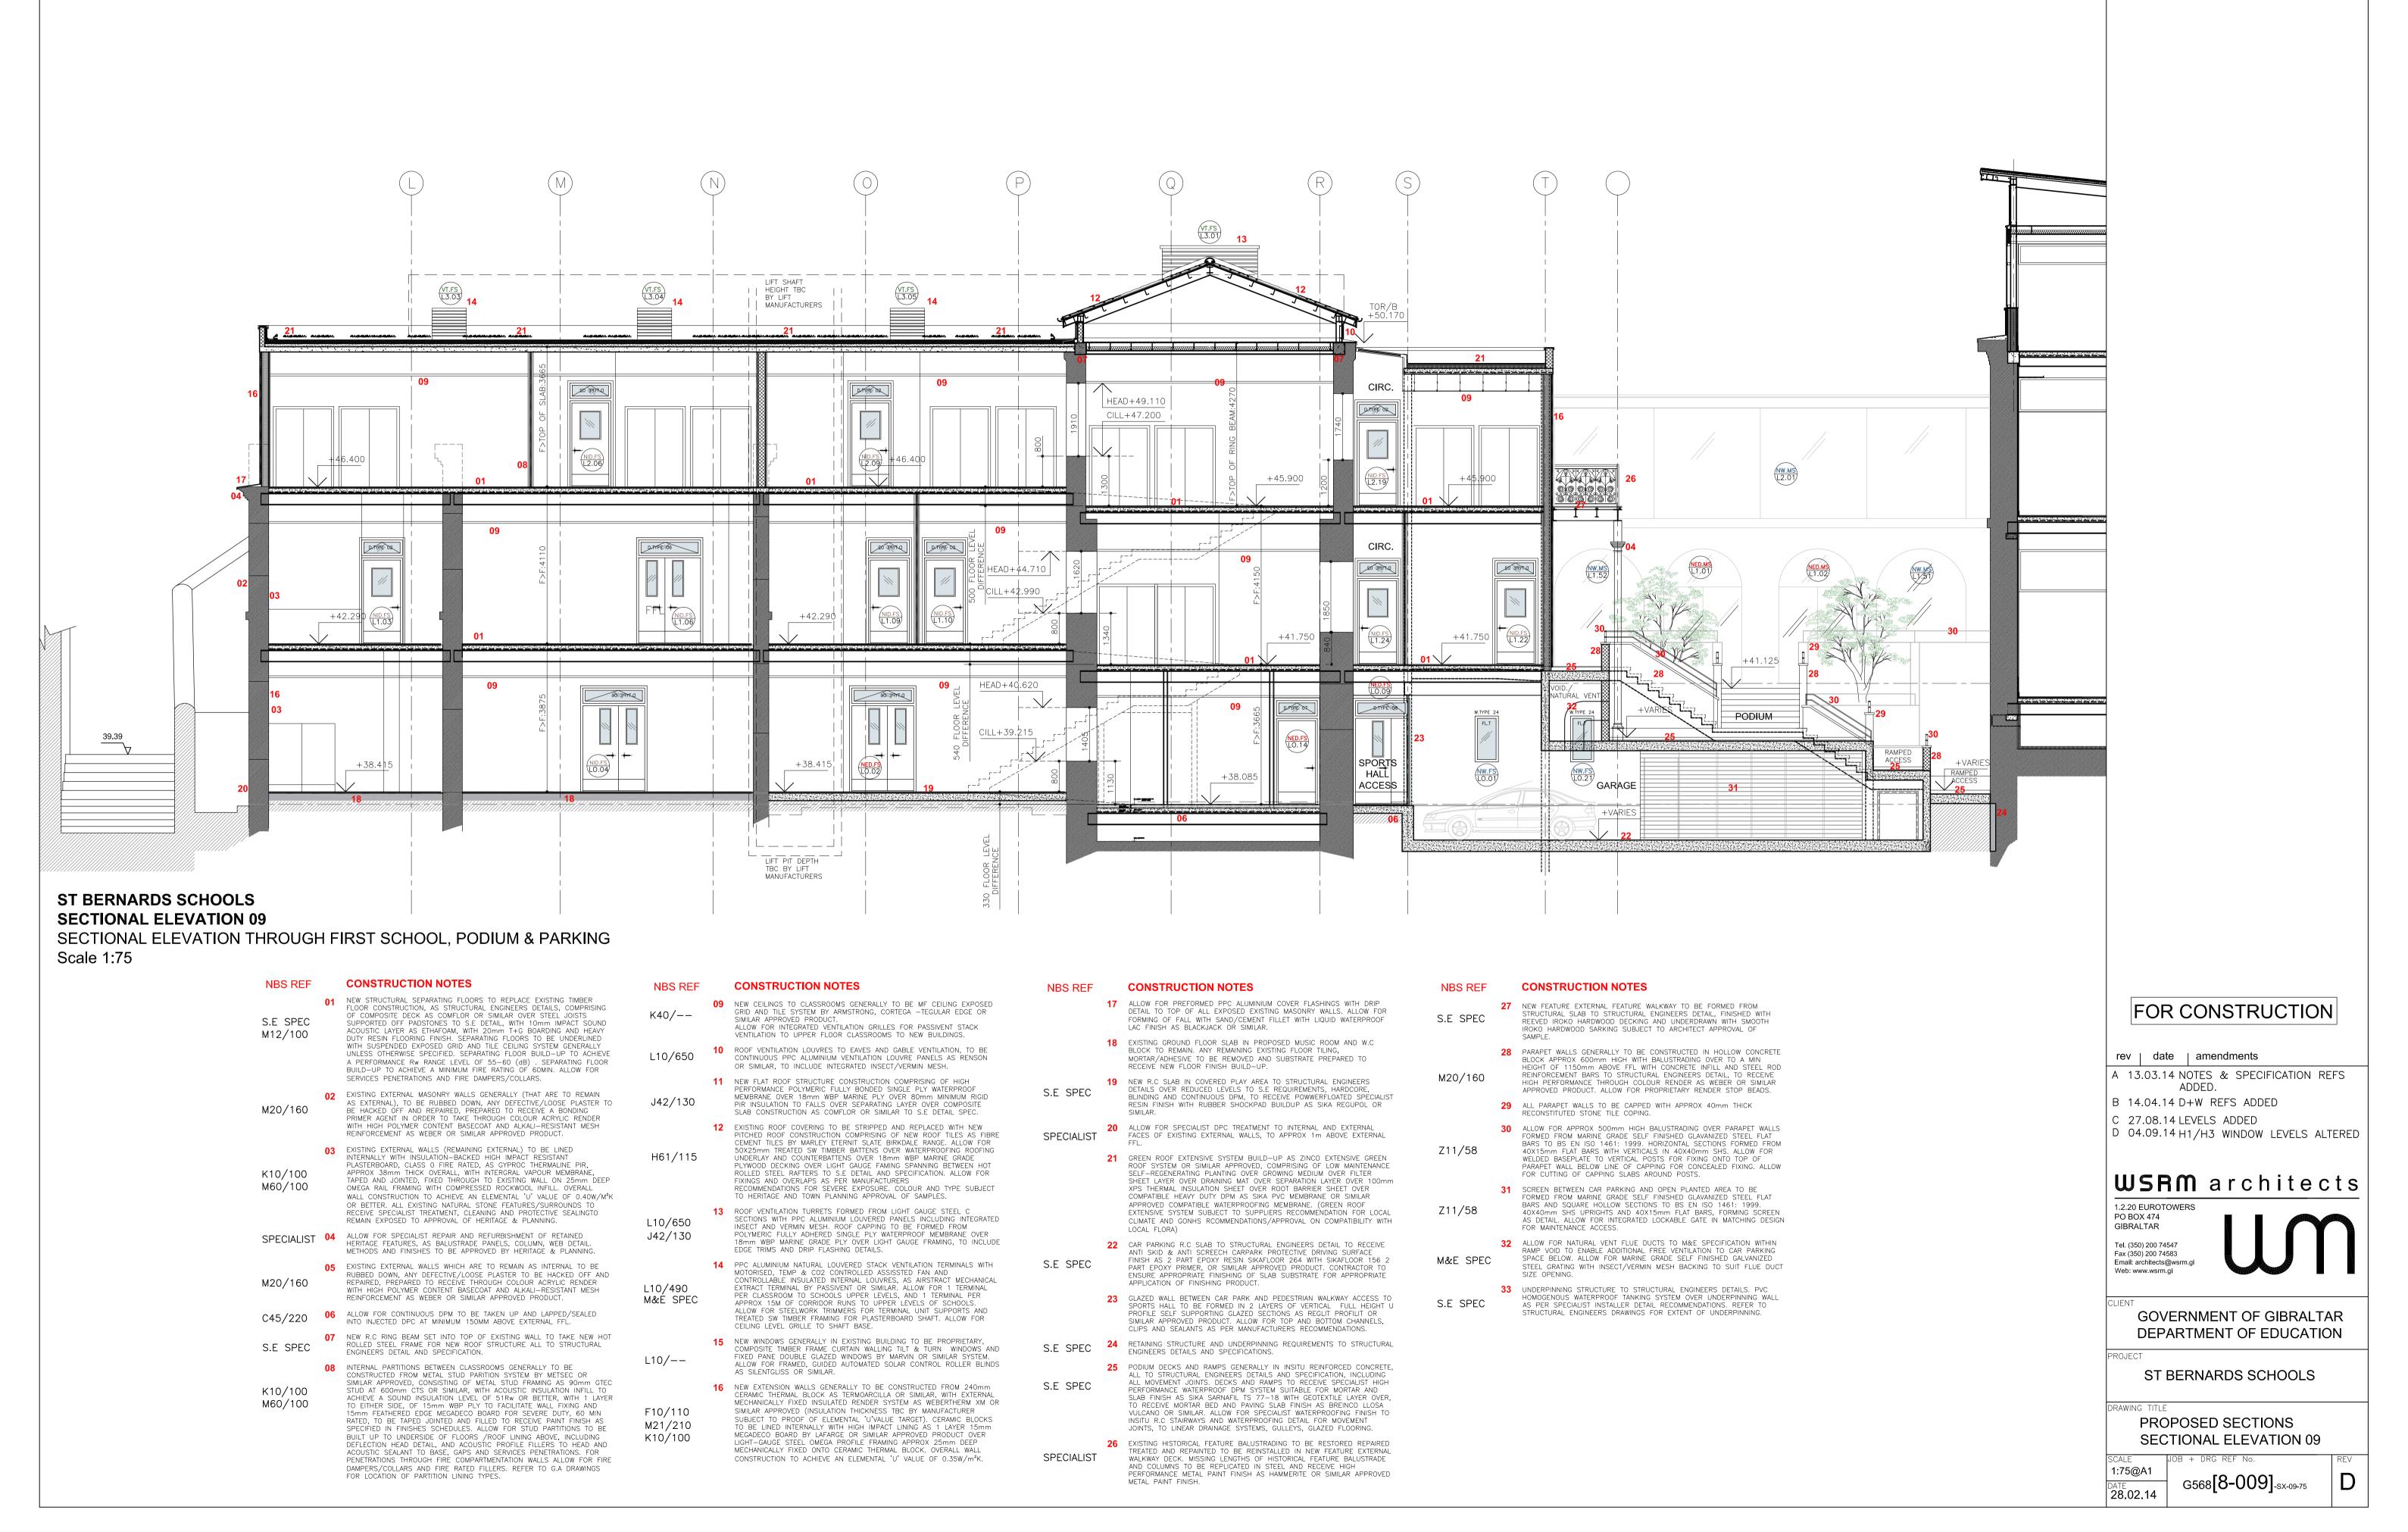

NOTES:

DO NOT SCALE OFF THIS DRAWING. CHECK DIMENSIONS ON SITE PRIOR TO COMMENCEMENT. THIS DRAWING IS THE COPYRIGHT OF WSRM ARCHITECTS LTD. AND MUST NOT BE COPIED OR REPRODUCED, IN PART OR IN WHOLE, WITHOUT PERMISSION OF WSRM ARCHITECTS LTD. TO BE

READ IN CONJUNCTION WITH OTHER RELEVANT

CONSULTANTS INFORMATION.

ST BERNARDS SCHOOLS **SECTIONAL ELEVATION 10**

SECTIONAL ELEVATION THROUGH SPORTS HALL AND FIRST SCHOOL Scale 1:75

WALL

NBS REF CONSTRUCTION NOTES

01 EXCAVATED FACE TO RECEIVE SACRIFICIAL SHUTTERING AS 11mm OSB BOARDING TO LARGE VOID AREAS IN ORDER TO ACCEPT PVC HOMOGENOUS WATERPROOF TANKING MEMBRANE SYSTEM BY SPECIALIST SUBCONTRACTOR AS SIKAPLAN OR SIMILAR TANKING SYSTEM, ALL BY SPECIALIST INSTALLER. EXISTING WALL FACE AT HIGH LEVEL TO BE PREPARED TO RECEIVE WATERPROOF TANKING MEMBRANE SYSTEM. REQUIREMENT FOR GEOTEXTILE PROTECTION LAYER AND PREPARATION OF SUBSTRATES ALL AS PER SPECIALIST SUPPLIER/INSTALLER DETAIL RECOMMENDATIONS

02 PVC HOMOGENOUS WATERPROOF TANKING MEMBRANE SYSTEM BY SPECIALIST TO BE TAKEN UP FULL LENGTH OF EXISTING WALL CONTINUING UP AND SEALED OVER NEWLY FORMED LOW BLOCKWORK WALL APPROX 450mm HIGH.

03 PVC HOMOGENOUS WATERPROOF TANKING MEMBRANE SYSTEM TO EXTEND MINIMUM 1.5m BELOW SLAB, TO BE LAPPED BONDED AND SEALED WITH CONTINUOUS 1200 GAUGE DPM, ALL AS PER SPECIALIST INSTALLER DETAIL RECOMMENDATIONS, ENSURING COMPATIBILITY WITH

S.E SPEC 04 retaining wall structure to structural engineers details cast up against pvc homogenous waterproof tanking system over excavated wall as per specialist installer detail RECOMMENDATIONS. REFER TO STRUCTURAL ENGINEERS DRAWINGS FOR EXTENT OF RETAINING WALL.

S.E SPEC 05 R.C SLAB TO STRUCTURAL ENGINEERS DETAIL TO RECEIVE POWER FLOATED FINISH IN ORDER TO RECEIVE SPORTS HALL INTERNAL FLOOR

S.E SPEC 06 LATTICE GIRDER TO STRUCTURAL ENGINEERS DETAILS TO RECEIVE SMOOTH SPRAY APPLIED INTUMESCENT PAINT FINISH, COLOUR TBC. 07 EXISTING BOUNDARY WALL TO BE REDUCED TO ACCOMMODATE NORTH FACING CLERESTORY WINDOWS

S.E SPEC 08 ROOF SLAB SPANNING OVER LATTICE GIRDERS TO STRUCTURAL ENGINEERS DETAILS. SPECIALIST

CONTINUOUS DPM TO BE TAKEN UP SIDES TO TOP OF SCREED LEVEL.
IN JUNCTIONS WITH CAVITY WALLS, DPM TO BE TAKEN UP INTERNAL
FACE OF EXTERNAL LEAF , TUCKED AND SEALED WITH DPC AT MINIMUM

150mm ABOVE EXTERNAL FFL 10 STEEL REINFORCED FLOATING SCREED TO S.E DETAIL WITH 125mm S.E SPEC
MINIMUM DEPTH TO ACCOMMODATE 25mm OPEN CHANNEL. FALLS IN SCREED TOWARDS OPEN CHANNEL DRAINAGE. ALLOW FOR NOMINAL SPECIALIST FALLS WITHIN OPEN DRAINAGE CHANNEL TOWARDS OUTLET POSITIONS. ALLOW FOR TROWEL FINISH TO SCREED IN PREPARATION FOR

SPECIALIST OUTDOOR SPORTS FLOORING FINISH.

NBS REF CONSTRUCTION NOTES

11 SPECIALIST OUTDOOR SPORTS FLOORING FINISH APPLIED DIRECTLY SPECIALIST ONTO SCREED. FINISH TO BE TAKEN UP AND SEALED INTO PERIMETER WALLS MINIMUM 150mm ABOVE FFL.

12 LOW LEVEL PERIMETER WALL TO EAST APPROX 1250mm HIGH. IN S.E SPEC HOLLOW CONCRETE BLOCK WITH STIFFENING RODS TO S.E DETAIL.
ALLOW FOR POCKETS TO TOP OF WALL TO TAKE POSTS FOR

> 13 PERIMETER POSTS AND FENCING SYSTEM, INCLUDING SAFETY NETTING OVER. AS PER GSLA RECOMMENDATIONS, SYSTEM TO BE APPROPRIATE FOR LOW LEVEL NOISE/REVERBERATION WITH LARGE DIAMETER BALL IMPACT. GSLA TO CONFIRM HEIGHT OF FENCING/NETTING, WITH CONSIDERATION TO NEARBY WINDOW HEIGHT POSITIONS.

14 SPORTS EQUIPMENT TO BE FIT FOR EXTERNAL USE IN HARSH ENVIRONMENTS, TYPE/QUANTITY TO BE CONFIRMED BY END USERS AND

15 SPORTS HALL WALLS TO BE LINED INTERNALLY WITH HIGH PRESSURE LAMINATED PANELS AS TRESPA METEON FR (FIRE RETARDANT GRADE) SYSTEM WITH CONCEALED FIXINGS. FIXING SYSTEM TO BOTTOM SECTION APPROX 2.5M HIGH, TO BE SUITABLE FOR INDOOR SPORTS AND IMPACT WITH LARGE DIAMETER BALLS. ALLOW FOR APPROX 15% OF WALL PANELS AT HIGH LEVEL TO BE PERFORATED WITH FIRE RATED BLACK ACOUSTIC FELT AND COMPRESSED 150mm NON-COMBUSTIBLE ACOUSTIC MINERAL WOOL BEHIND AS ISOWOOL OR SIMILAR. BEHIND AS ISOWOUL OR SIMILAR.
ALLOW FOR CONTINUOUS 50mm ACOUSTIC INSULATION LAYER AS
ISOWOOL OR SIMILAR TO SEPARATING WALL WITH SCHOOL.

16 ROOFTOP SPORTS PITCH SLAB TO BE UNDERDRAWN WITH ACOUSTIC PLASTERBOARD MF SUSPENDED CEILING SYSTEM AS GYPROC GYPTONE LINE 6, 13% PERFORATION AND ACOUSTIC TISSUE, WITH 150mm NON-COMBUSTIBLE MINERAL WOOL INSULATION AS ISOWOOL OR SIMILAR

17 HIGH LEVEL CLERESTORY WINDOWS TO NORTH ELEVATION IN THERMALLY BROKEN PPC COATED ALUMINIUM FRAMES WITH DOUBLE GLAZING AS TECHNAL OR SIMILAR APPROVED. ALLOW FOR APPROX ONE THIRD OF GLAZED LIGHTS TO BE OPENABLE, TOP HUNG, WITH REMOTE MOTORISED OPENING. ALL GLAZING PANELS TO HAVE FIXED FRAMED DIM-OUT BLINDS WITH REMOTE MOTORISED CONTROL AS SILENTGLISS OR SIMILAR

> 18 EXTERNAL WALL CONSTRUCTED FROM 140mm INTERNAL DENSE CONCRETE BLOCK WITH 60mm CAVITY AND 140mm EXTERNAL DENSE CONCRETE BLOCK, 60mm FULL FILL BATTS INSULATION. CAVITY WALL EXTERNALLY TO TAKE THROUGH COLOUR ACRYLIC RENDER WITH HIGH POLYMER CONTENT BASECOAT AS AND ALKALI-RESISTANT MESH REINFORCEMENT AS WEBER OR SIMILAR APPROVED PRODUCT. NBS REF M20/160. REFER TO GENERAL ARRANGEMENT PLANS FOR INTERNAL WALL FINISHES/LININGS.

NBS REF CONSTRUCTION NOTES


DETAILS OVER REDUCED LEVELS TO S.E REQUIREMENTS, HARDCORE,
BLINDING AND CONTINUOUS DPM, TO RECEIVE POWWERFLOATED
SPECIALIST RESIN FINISH WITH RUBBER SHOCKPAD BUILDUP AS SIKA

> 20 AREA OUTSIDE COVERED PLAY ZONE TO BE 100mm DEEP RUBBER CRUMB SAFETY FLOORING. ALL OTHER EXTERNAL AREAS TO RECEIVE EXTERNAL CONCRETE TILES AS LLOSA VULCANO OR SIMILAR. REFER TO GENERAL ARRANGEMENT PLANS FOR FLOOR FINISHES G568[5-000]

21 INTERNAL PARTITIONS IN LIGHT GAUGE STEEL STUDS — REFER TO GENERAL ARRANGEMENT PLANS G568[5-000] SERIES DRAWINGS FOR HEAD DETAILS TO ALL LIGHT GAUGE STEEL STUD PARTITIONS. 22 NEW STRUCTURAL SEPARATING FLOORS TO REPLACE EXISTING TIMBER

S.E SPEC FLOOR CONSTRUCTION, AS STRUCTURAL ENGINEERS DETAILS, COMPRISING OF COMPOSITE DECK AS COMFLOR OR SIMILAR OVER STEEL JOISTS TO S.E DETAIL, WITH 10mm IMPACT SOUND ACOUSTIC LAYER AS ETHAFOAM, WITH 20mm T+G BOARDING AND HEAVY DUTY RESIN FLOORING FINISH. SEPARATING FLOORS TO BE UNDERLINED WITH SUSPENDED EXPOSED GRID AND TILE CEILING SYSTEM GENERALLY JNLESS OTHERWISE SPECIFIED. SEPARATING FLOOR BUILD-UP TO ACHIEVE A PERFORMANCE RW RANGE LEVEL OF 55-60 (dB) . SEPARATING FLOOR BUILD-UP TO ACHIEVE A MINIMUM FIRE RATING OF 60MIN. ALLOW FOR SERVICES PENETRATIONS AND FIRE DAMPERS/COLLARS.

> 23 UNDERSIDE OF FLOOR SLAB TO BE UNDERDRAWN WITH EXTERNAL RENDER BASE BOARD AS LAFARGE GTEC RENDERBOARD OR BLUCLAD OR SIMILAR CEMENTITIOUS CALCIUM SILICATE RENDER BASE BOARD FIXINGS TO BOARD MANUFACTURERS DETAIL RECOMMENDATIONS, WITH 150mm MINERAL WOOL INSULATION INFILL AS ISOWOOL OR SIMILAR TO ACHIEVE TARGET ELEMENTAL VALUE OF 0.25W/m²K. RENDER BASE BOARD TO TAKE THROUGH COLOUR ACRYLIC RENDER FINISH WITH HIGH POLYMER CONTENT BASECOAT AND ALKALI-RESISTANT MESH REINFORCEMENT AS WEBER OR SIMILAR APPROVED PRODUCT.

24 SUSPENDED EXPOSED GRID AND TILE MF CEILING SYSTEM. REFER TO REFLECTED CEILING LAYOUTS G568[6-000]SERIES DRAWINGS FOR

S.E SPEC 25 ROOF SLAB TO STRUCTURAL ENGINEERS DETAIL TO TAKE 1200 GAUGE DPM TAKEN UP SIDES TO TOP OF INTERNAL FACE OF PARAPET WALL, S.E SPEC 26 SCREED TO FALLS AS PER STRUCTURAL ENGINEERS SPECIFICATION

27 GREEN ROOF EXTENSIVE SYSTEM BUILD-UP AS ZINCO EXTENSIVE GREEN ROOF SYSTEM OR SIMILAR APPROVED, COMPRISING OF LOW MAINTENANCE SELF-REGENERATING PLANTING OVER GROWING MEDIUM OVER FILTER SHEET LAYER OVER DRAINING MAT OVER SEPARATION LAYER OVER 100mm XPS THERMAL INSULATION SHEET OVER ROOT BARRIER SHEET OVER COMPATIBLE HEAVY DUTY DPM AS SIKA PVC MEMBRANE OR SIMILAR APPROVED COMPATIBLE WATERPROOFING MEMBRANE. (GREEN ROOF EXTENSIVE SYSTEM SUBJECT TO SUPPLIERS RECOMMENDATION FOR LOCAL CLIMATE AND GONHS RCOMMENDATIONS/APPROVAL ON COMPATIBILITY WITH LOCAL FLORA)

NBS REF CONSTRUCTION NOTES

28 PARAPET CAPPING PIECE FORMED FROM PREFORMED PPC ALUMINIUM TO PROFILE INCLUDING FIXING CLIPS FOR CONCEALED FIXING.

29 EXISTING EXTERNAL MASONRY WALLS GENERALLY (THAT ARE TO REMAIN M20/160

AS EXTERNAL), TO BE RUBBED DOWN, ANY DEFECTIVE/LOOSE PLASTER TO BE HACKED OFF AND REPAIRED, PREPARED TO RECEIVE A BONDING PRIMER AGENT IN ORDER TO TAKE THROUGH COLOUR ACRYLIC RENDER WITH HIGH POLYMER CONTENT BASECOAT AND ALKALI-RESISTANT MESH REINFORCEMENT AS WEBER OR SIMILAR APPROVED PRODUCT.

30 PROPRIETARY, THERMALLY BROKEN ALUMINIUM CURTAIN WALLING TILT & TURN AND FIXED PANE DOUBLE GLAZED WINDOWS BY TECHNAL REF TECHNAL OR SIMILAR APPROVED SYSTEM, WITH VERTICALLY EXPRESSED EXTERNAL MULLIONS. ALLOW FOR GLAZED INSULATED SPANDREL PANEL SECTIONS AT HIGH LEVEL.

31 PROPRIETARY, THERMALLY BROKEN ALUMINIUM CURTAIN WALLING TOP H11/-HUNG AND FIXED PANE DOUBLE GLAZED WINDOWS WITH CONCEALED FRAMES AND EXTERNALLY EXPRESSED JOINTS BY TECHNAL REF TECHNAL REF SSG SYSTEM. ALLOW FOR GLAZED INSULATED SPANDREL PANEL SECTIONS AT HIGH LEVEL.

32 HORIZONTAL BRISE-SOLEIL SYSTEM WITH FIXED CONTINUOUS SEMIELLIPTICAL FINS IN PPC ALUMINIUM AS SUNEAL BY TECHNAL OR SIMILAR. APPROX DIMS. 225X75mm. ALLOW FOR SUPPORT STRUCTURE SPANNING BETWEEN FEATURE HORIZONTAL PFC CHANNELS TO SPECIALIST MANUFACTURER/INSTALLER REQUIREMENTS.

S.E SPEC

33 HORIZNTAL FEATURE PFC CHANNEL 300mm DEEP, IN MARINE GRADE GALVANIZED STEEL, PREPARED WITH CHEMICAL ETCHING MORDANT SOLUTION BY DULUX OR SIMILAR IN ORDER TO RECEIVE HIGH PERFORMANCE METAL PAINT FINISH AS HAMMERITE OR SIMILAR, RAL

M61/110 34 EXTERNAL CIRCULAR STRUCTURAL STEEL COLUMN TO RECEIVE SMOOTH SPRAY APPLIED INTUMESCENT PAINT FINISH. 35 GLAZED FOLDING SLIDING SCREEN DOUBLE GLAZED WITH PPC

ALUMINIUM THERMALLY BROKEN FRAMES AS TECHNAL PPM FOLDING DOOR SYSTEM OR SIMILAR. STRUCTURAL ENGINEERS TO ALLOW FOR HEAD RAIL FIXING OF SUSPENDED FOLDING DOORS, ALLOW FOR OTTOM SUNKEN EMBEDDED THRESHOLD & GUIDE, FIT FOR SEVERE

Z11/58

MARINE GRADE GALVANIZED STEEL HANDRAIL TO MAKE UP MINIMUM HEIGHT FROM FFL AT 1200mm.

M&E SPEC 38 ALLOW FOR SLAB LEVEL GULLEY WITH FINE GRADE FIBRE MESH TO PROVIDE FREE DRAINAGE BELOW RUBBER CRUMB FINISH, CONNECTED TO EXISTING DRAINAGE.

S.E SPEC

WHETHER EXISTING WALL IS TO REMAIN. ALL EXISTING REMAINING PERIMETER MASONRY WALLS TO BE REPAIRED AND PREPARED TO RECEIVE HIGH PERFORMANCE THROUGH COLOUR ACRYLIC RENDER WITH HIGH POLYMER CONTENT BASECOAT AND ALKALI-RESISTANT MESH REINFORCEMENT AS WEBER OR SIMILAR APPROVED PRODUCT

FOR CONSTRUCTION

rev | date | amendments

NOTES:

DO NOT SCALE OFF THIS DRAWING. CHECK DIMENSIONS ON SITE PRIOR TO COMMENCEMENT. THIS DRAWING IS THE COPYRIGHT OF WSRM ARCHITECTS LTD. AND MUST NOT BE COPIED OR REPRODUCED, IN PART OR IN WHOLE, WITHOUT PERMISSION OF WSRM ARCHITECTS LTD. TO BE

READ IN CONJUNCTION WITH OTHER RELEVANT

CONSULTANTS INFORMATION.

A 13.03.14 NOTES & SPECIFICATION REFS ADDED. TANKING DETAILS AMENDED FOLLOWING SPECIALIST DESIGN RECCOMMENDATIONS

B 14.04.14 D+W REFS ADDED

WSRM architects

PO BOX 474 **GIBRALTAR**

1.2.20 EUROTOWERS

Tel. (350) 200 74547 Fax (350) 200 74583 Email: architects@wsrm.gi Web: www.wsrm.gi


> **GOVERNMENT OF GIBRALTAR** DEPARTMENT OF EDUCATION


PROJECT ST BERNARDS SCHOOLS


DRAWING TITLE PROPOSED SECTIONS **SECTIONAL ELEVATION 10**


1:75@A1 28.02.14


G568[8-010]-SX-10-75

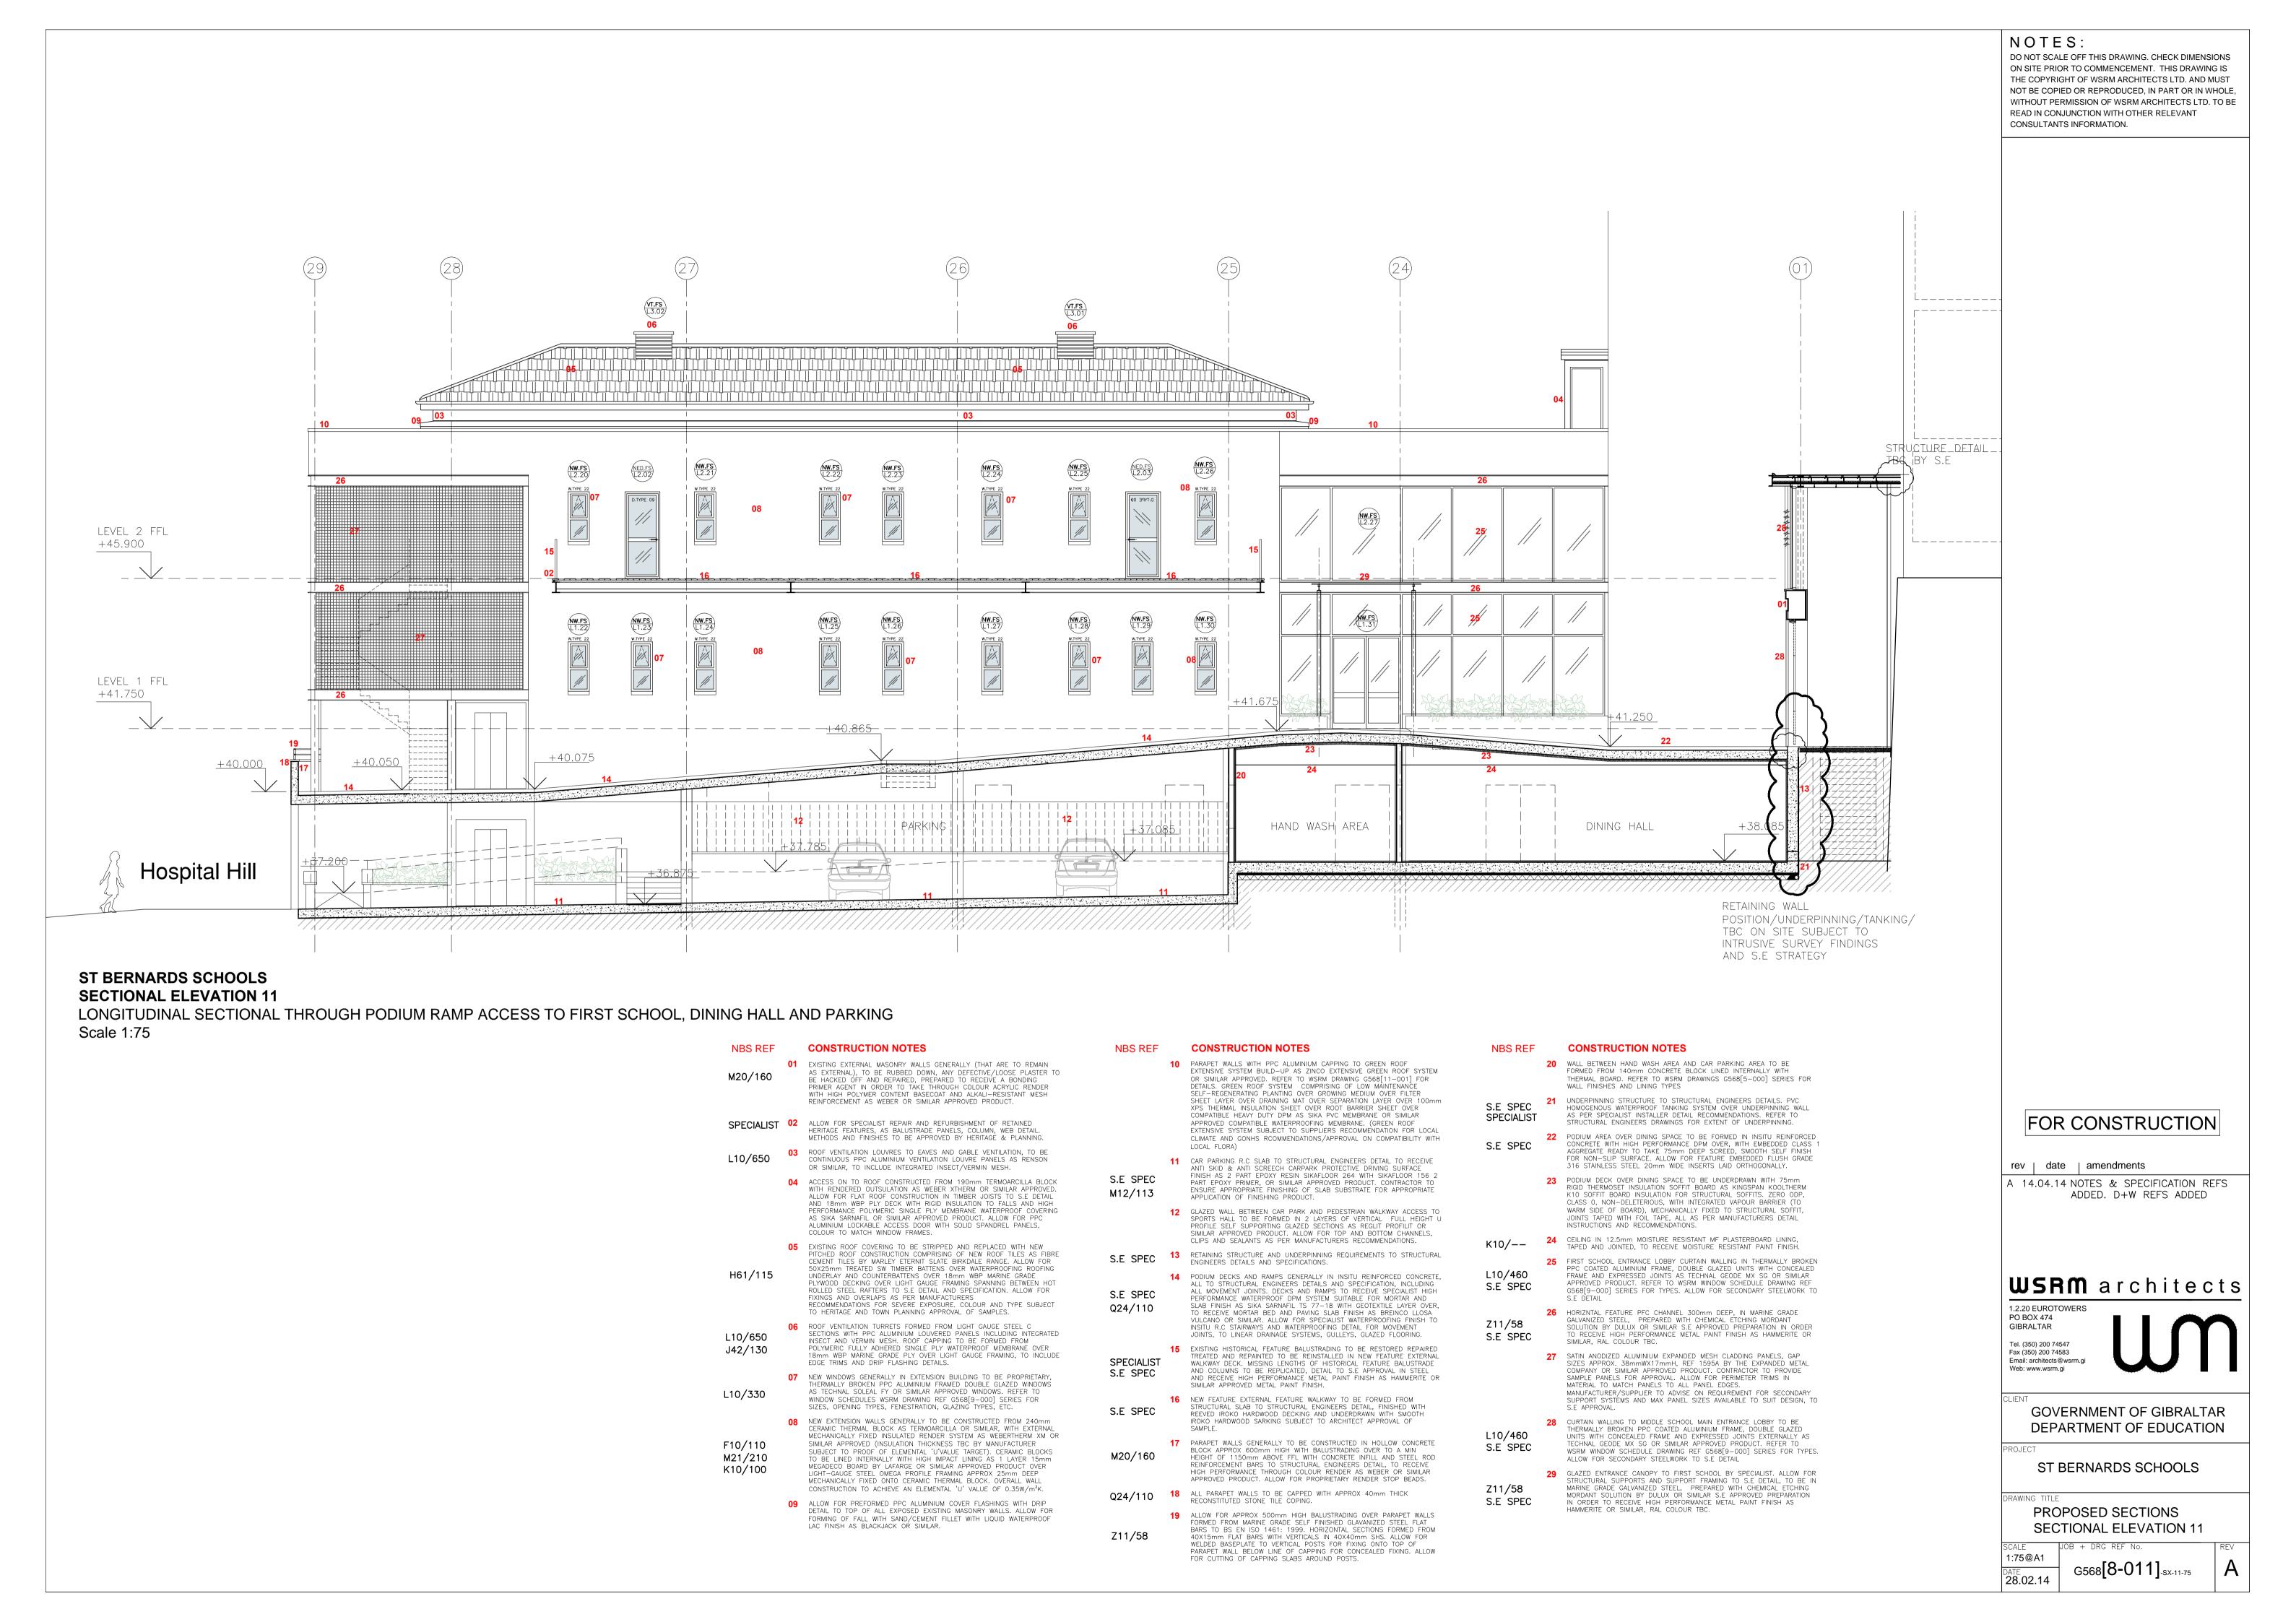

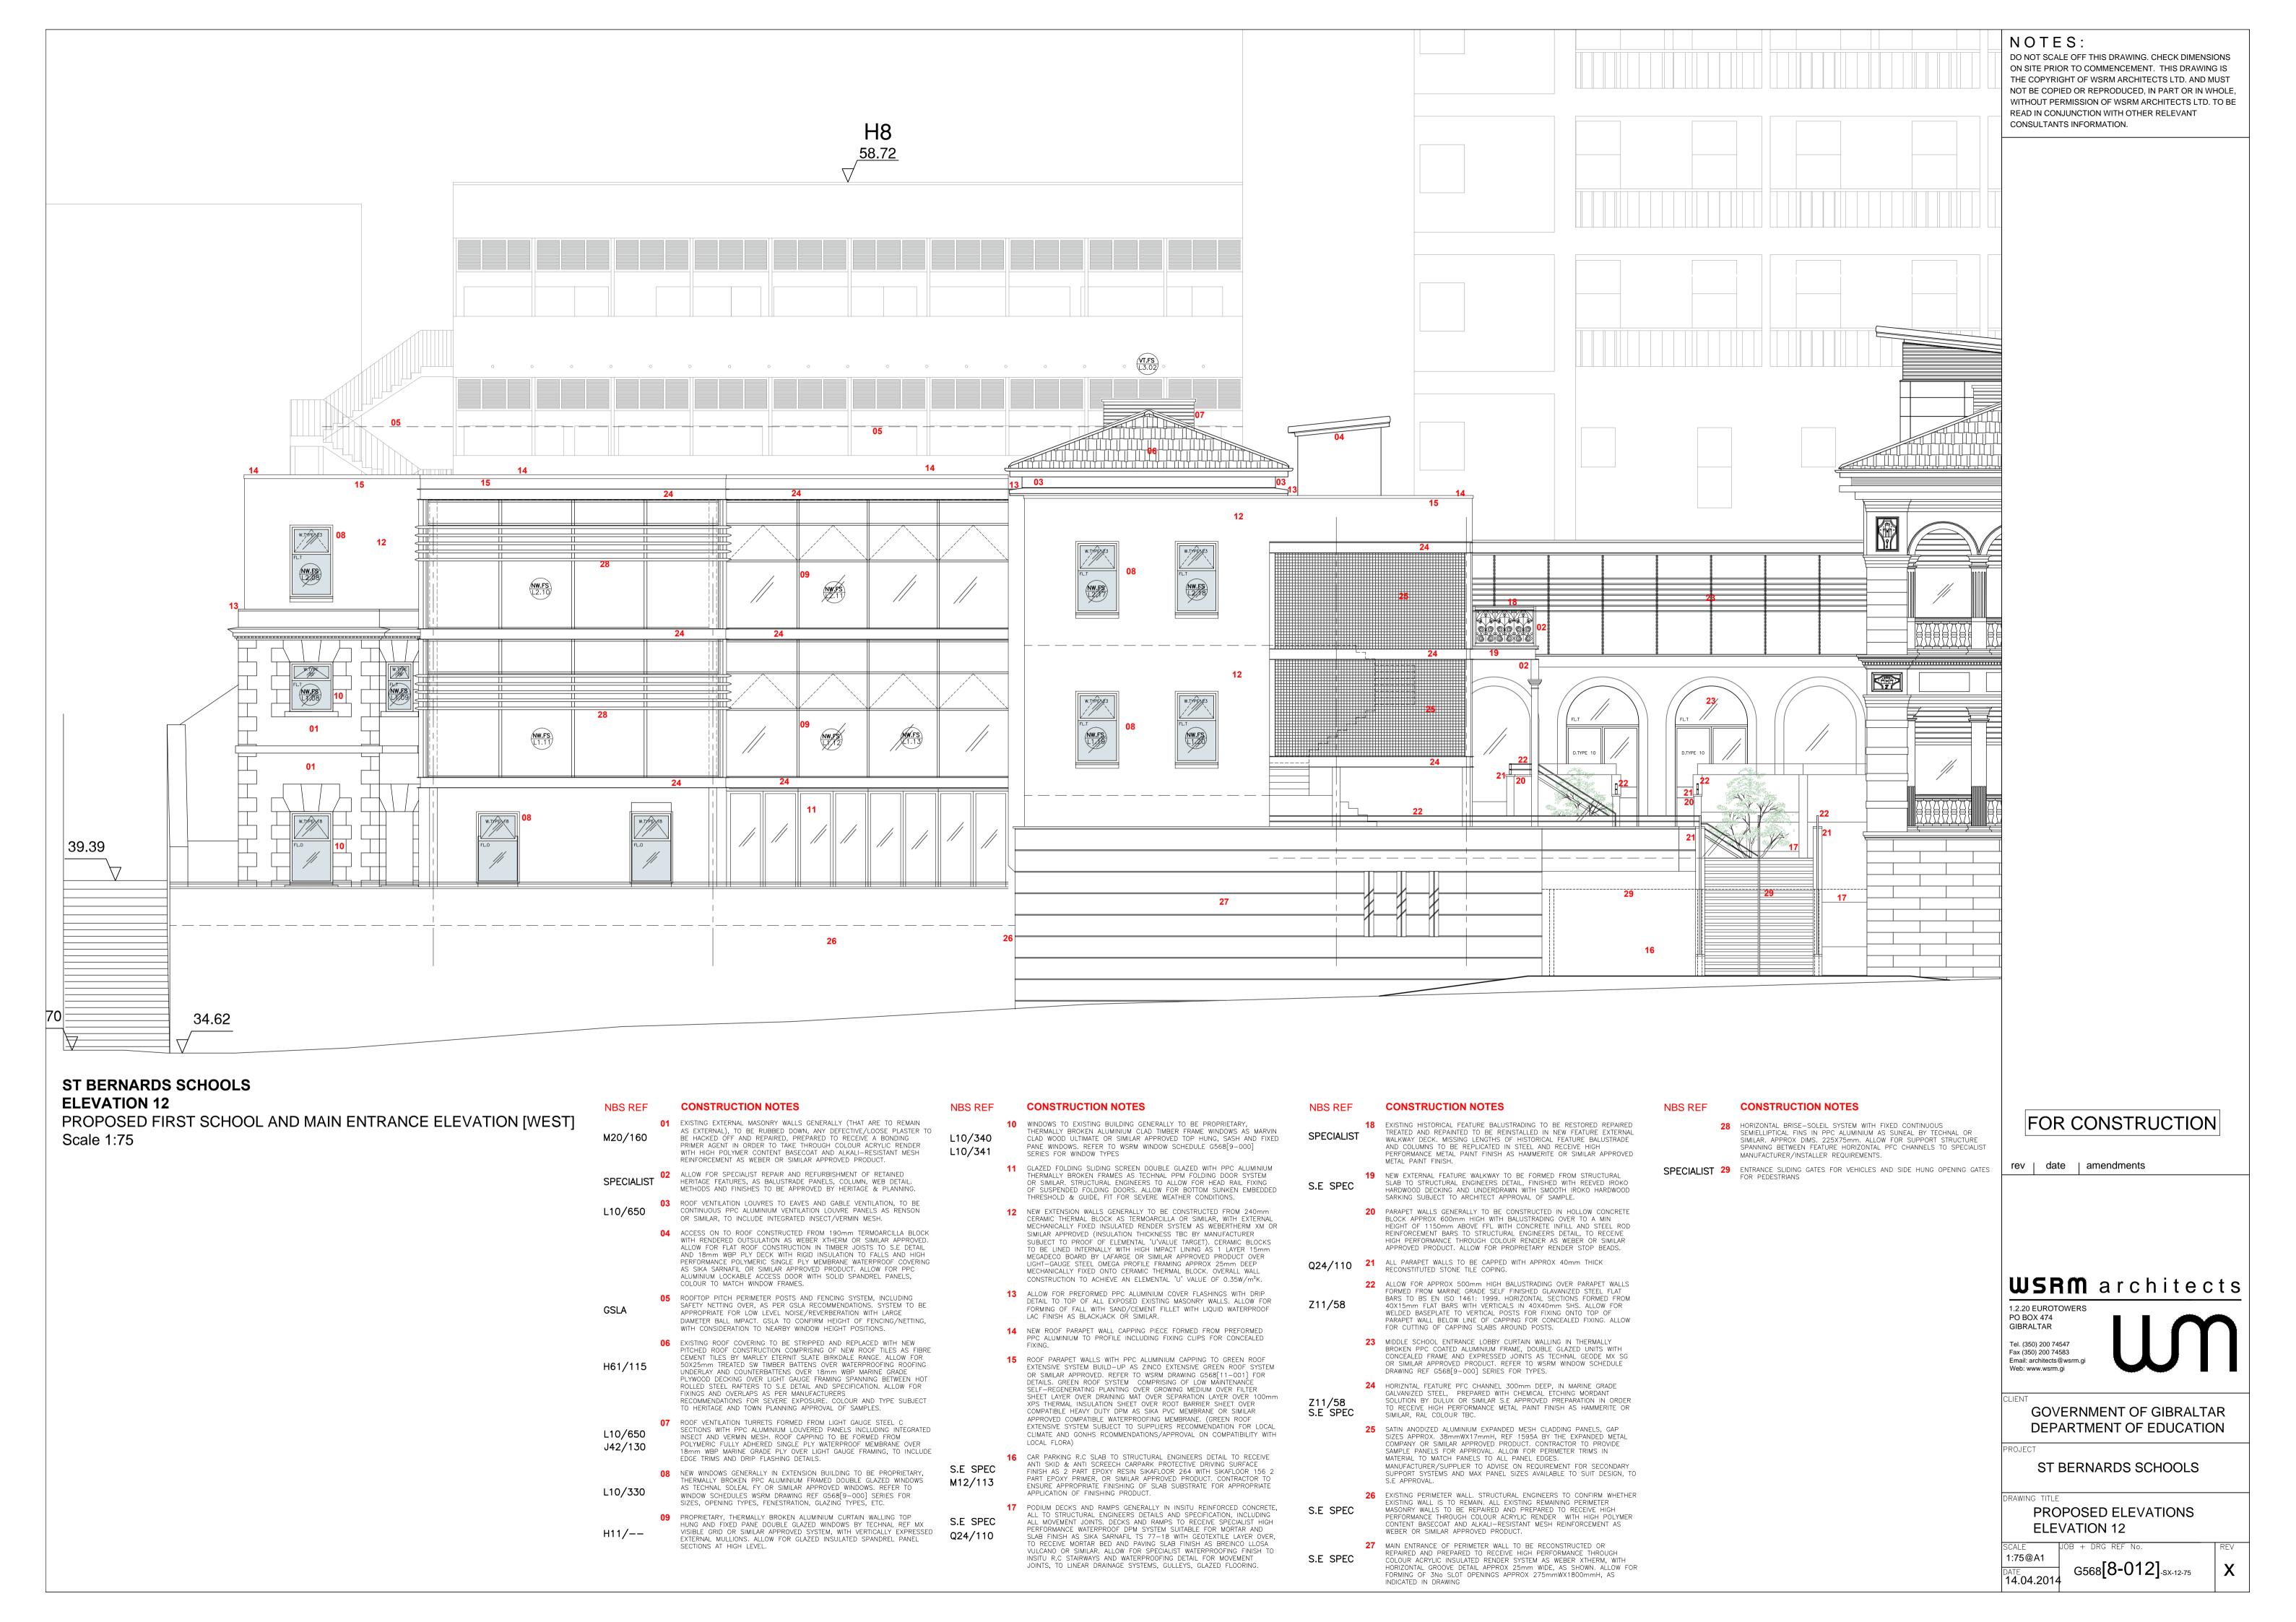

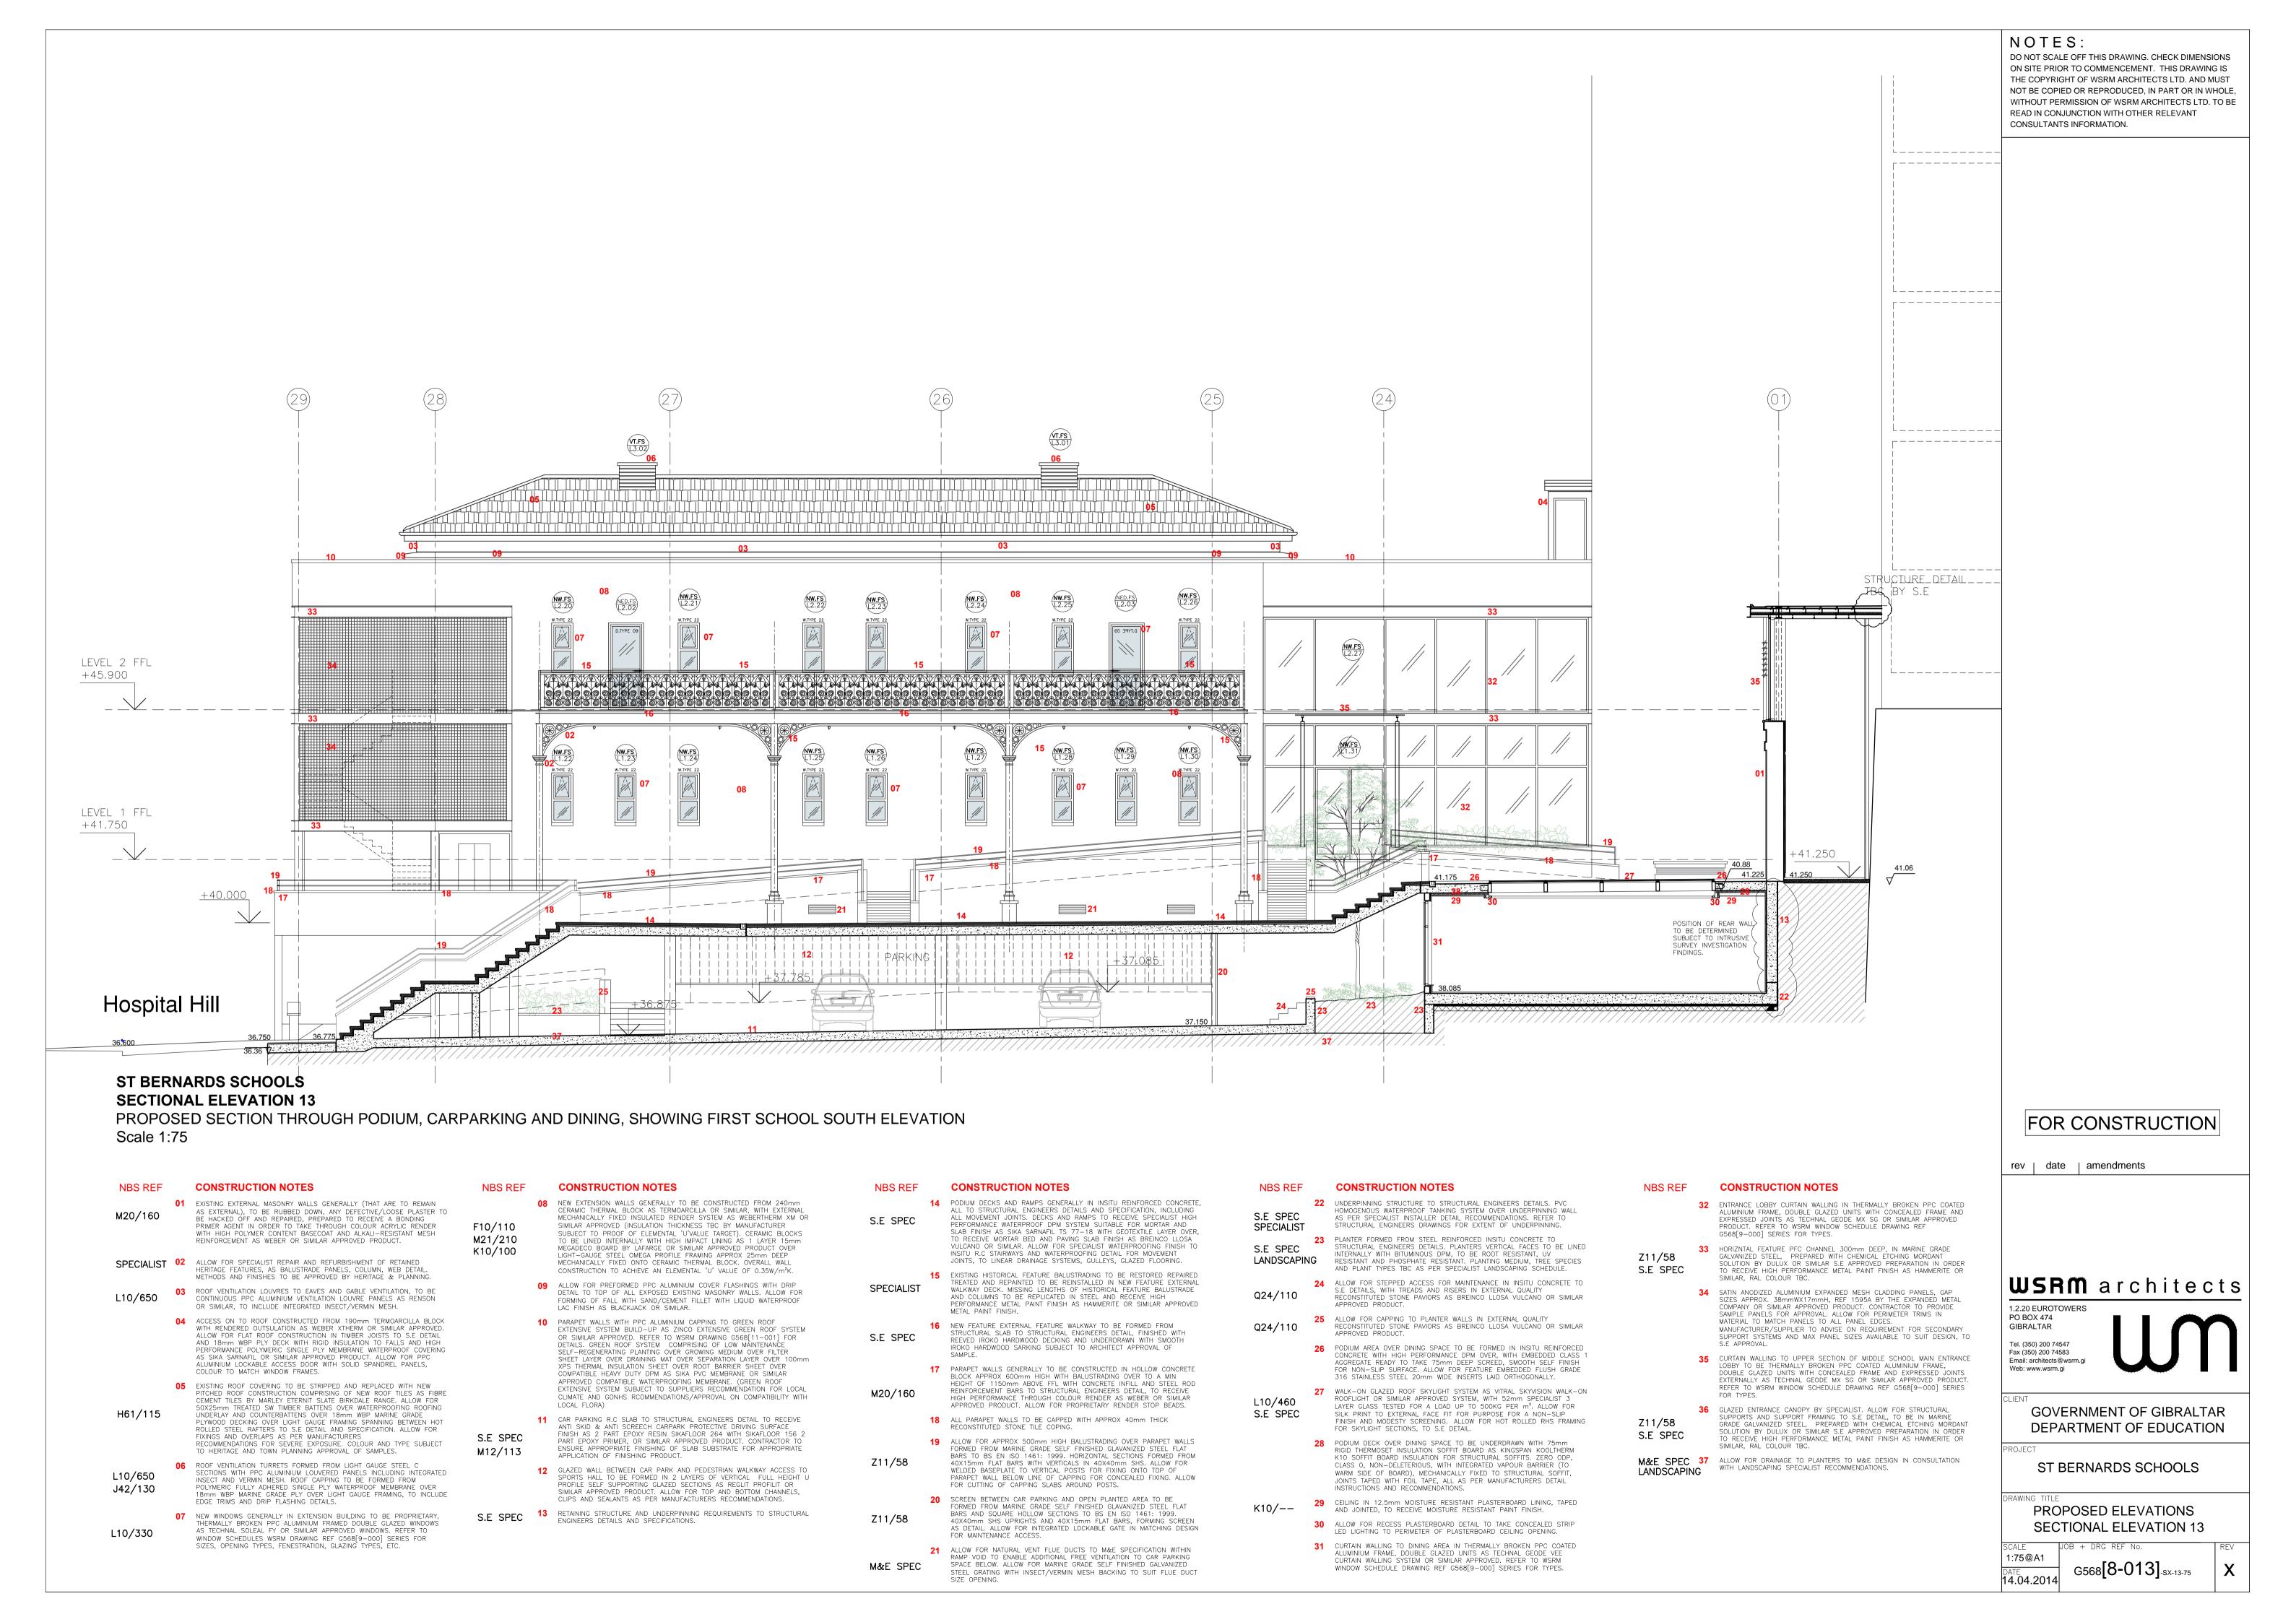

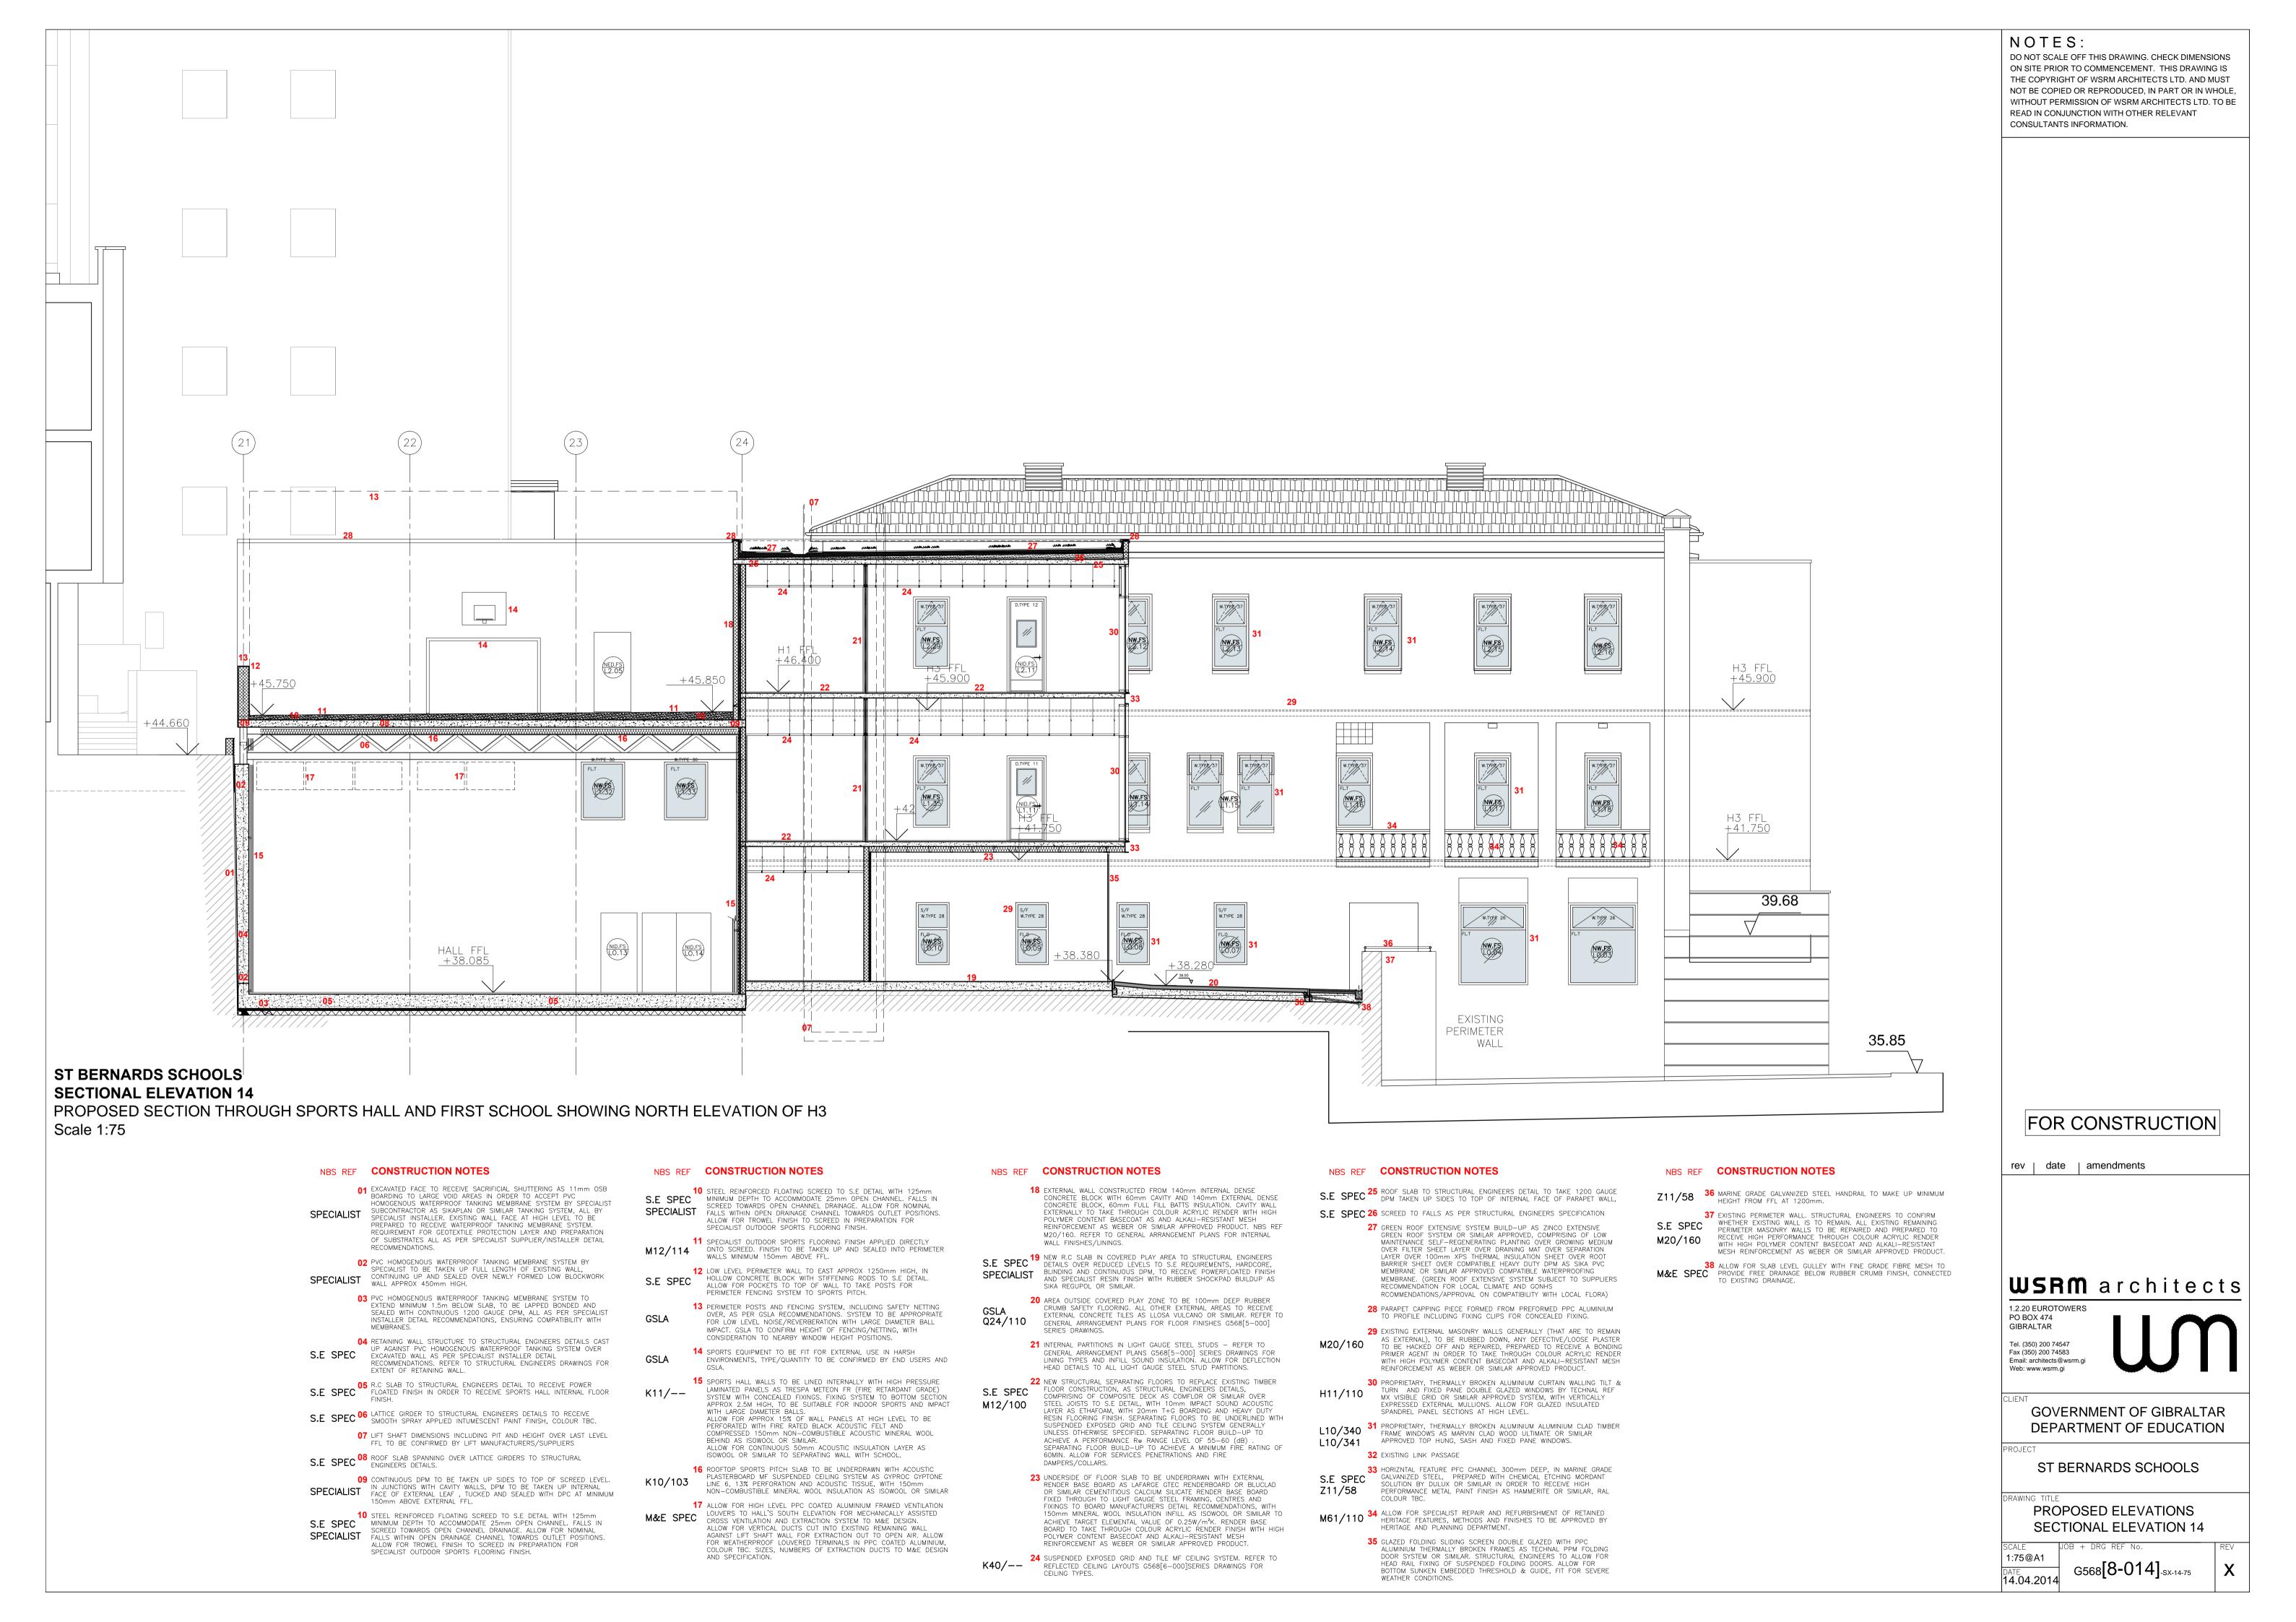

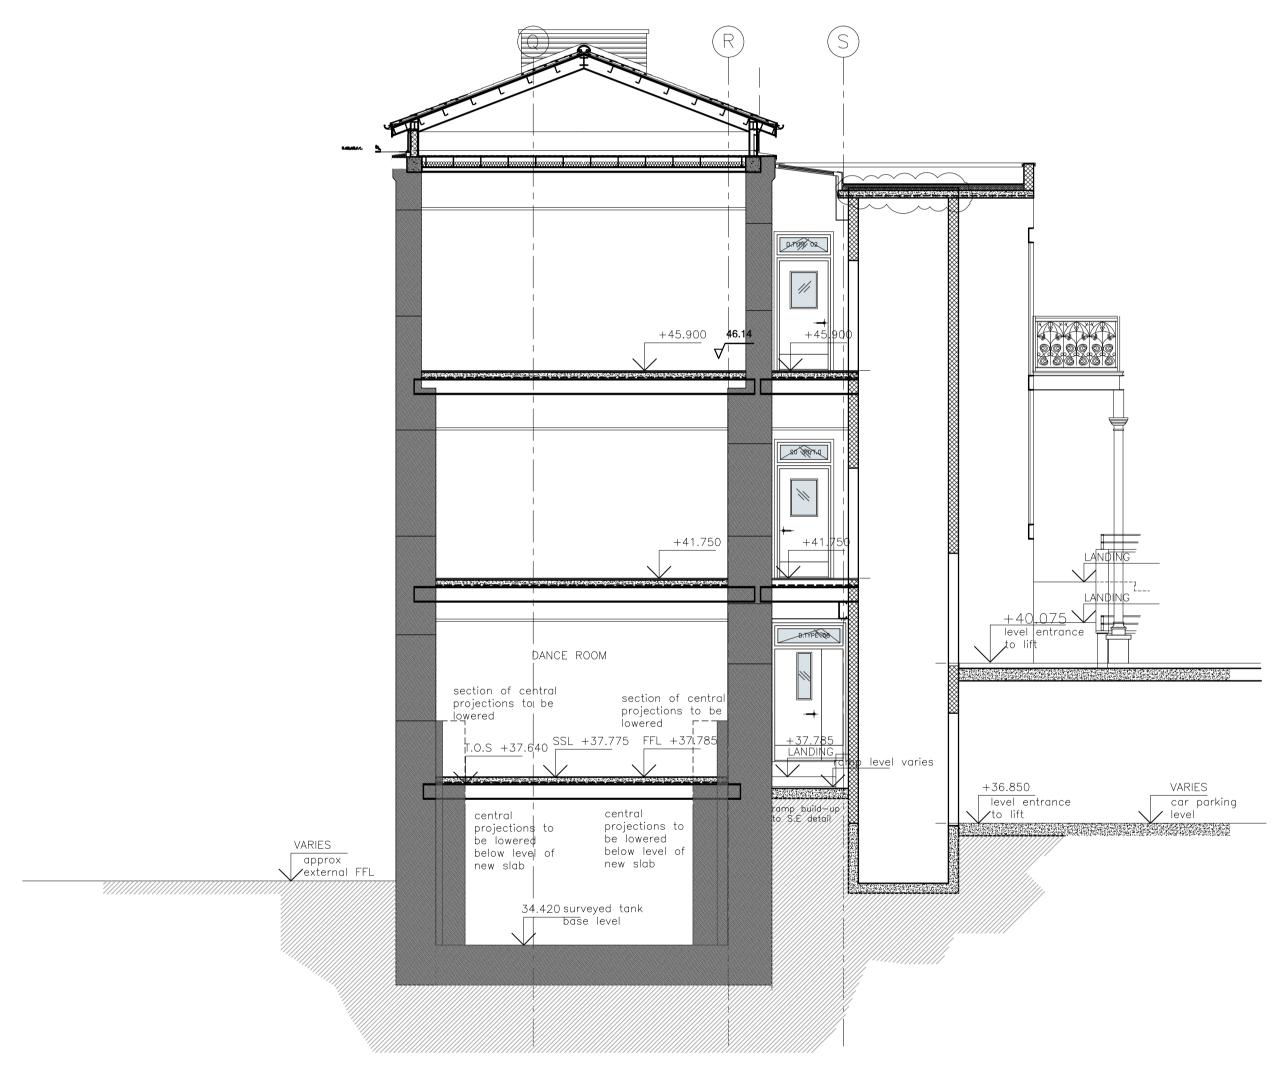

ST BERNARDS SCHOOLS **SECTIONAL 15**

PART SECTION THROUGH H3 WEST THROUGH DANCE ROOM Scale 1:75

NOTES:

DO NOT SCALE OFF THIS DRAWING. CHECK DIMENSIONS ON SITE PRIOR TO COMMENCEMENT. THIS DRAWING IS THE COPYRIGHT OF WSRM ARCHITECTS LTD. AND MUST NOT BE COPIED OR REPRODUCED, IN PART OR IN WHOLE, WITHOUT PERMISSION OF WSRM ARCHITECTS LTD. TO BE READ IN CONJUNCTION WITH OTHER RELEVANT CONSULTANTS INFORMATION.

FOR CONSTRUCTION

rev | date | amendments

WSRM architects

1.2.20 EUROTOWERS PO BOX 474 GIBRALTAR

Tel. (350) 200 74547 Fax (350) 200 74583 Email: architects@wsrm.gi Web: www.wsrm.gi

GOVERNMENT OF GIBRALTAR DEPARTMENT OF EDUCATION

drawing title

ST BERNARDS SCHOOLS

PROPOSED SECTIONAL ELEVATION 15

G568[8-015]-SX-15-75